


Leave off 6°
area

T. IIS. R. IW. W.M.

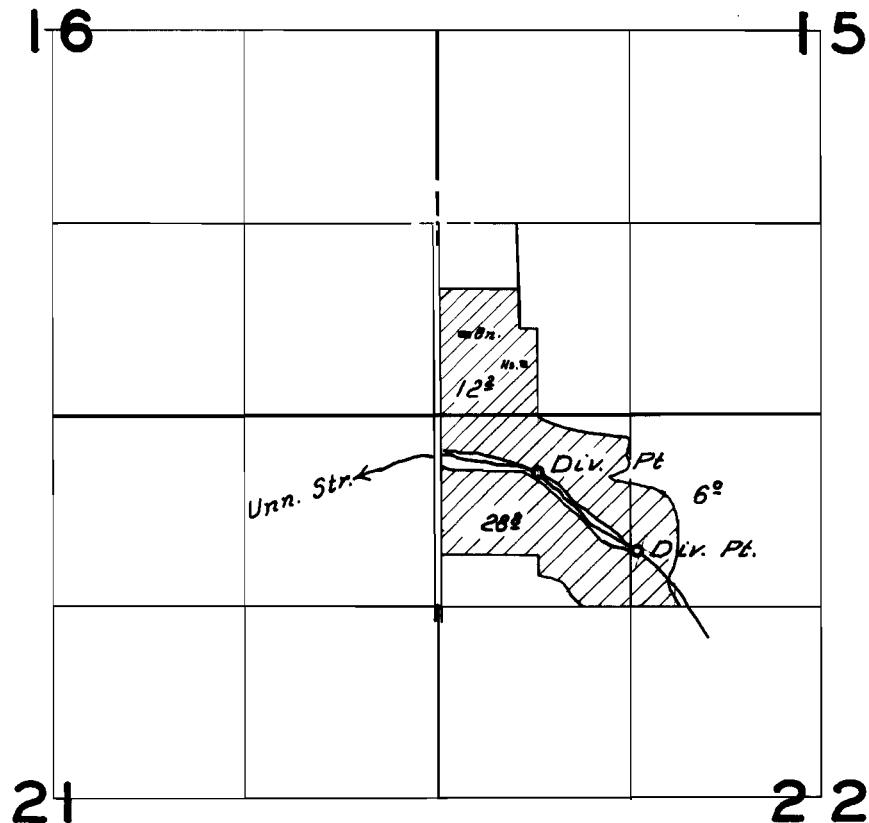

FINAL PROOF SURVEY

UNDER

Application No. 24266 Permit No. 19046

IN NAME OF

A. R. Hannaford

Surveyed Sept. 1, 1959, by R. H. Jackson