


T. 7&8S. R. 3&4W. W.M.

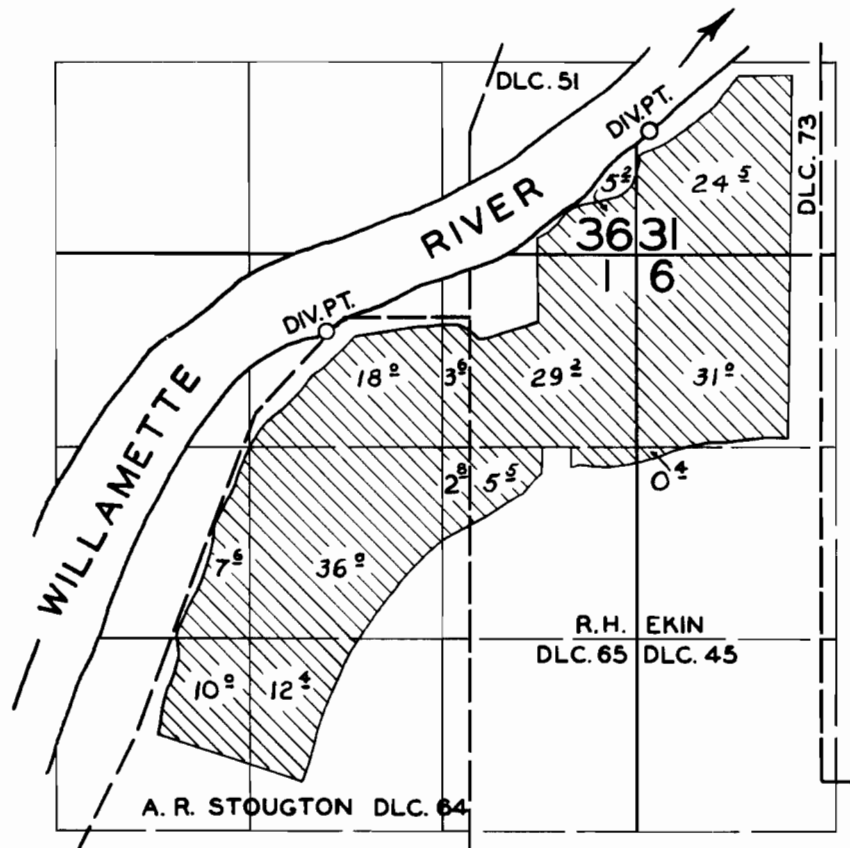

FINAL PROOF SURVEY
UNDER

Application No. 28660 Permit No. 22571
IN NAME OF

FRED C. RITNER

Surveyed JULY 2, 1957, by *C. C. Bartlett*