


T.5S.R.2W.W.M.

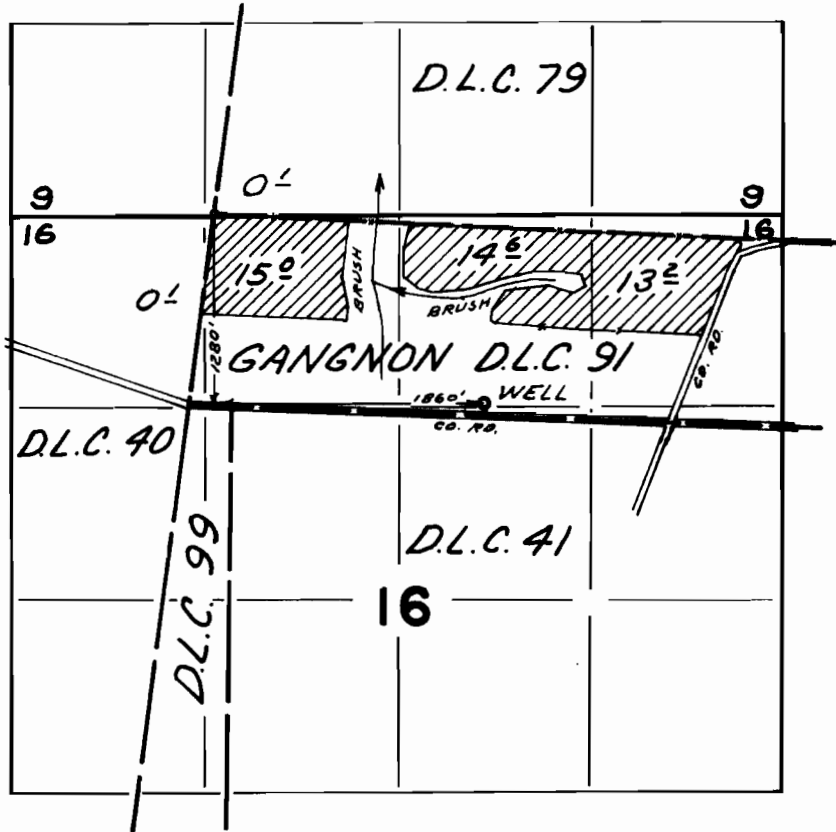

FINAL PROOF SURVEY
UNDER

Application No. G-3125 Permit No. G-2917
IN NAME OF

LEONARD R. FERSCHWEILER

Surveyed SEP. 28 1966, by V. GARNER