


T.35S.R.2&3W.W.M.

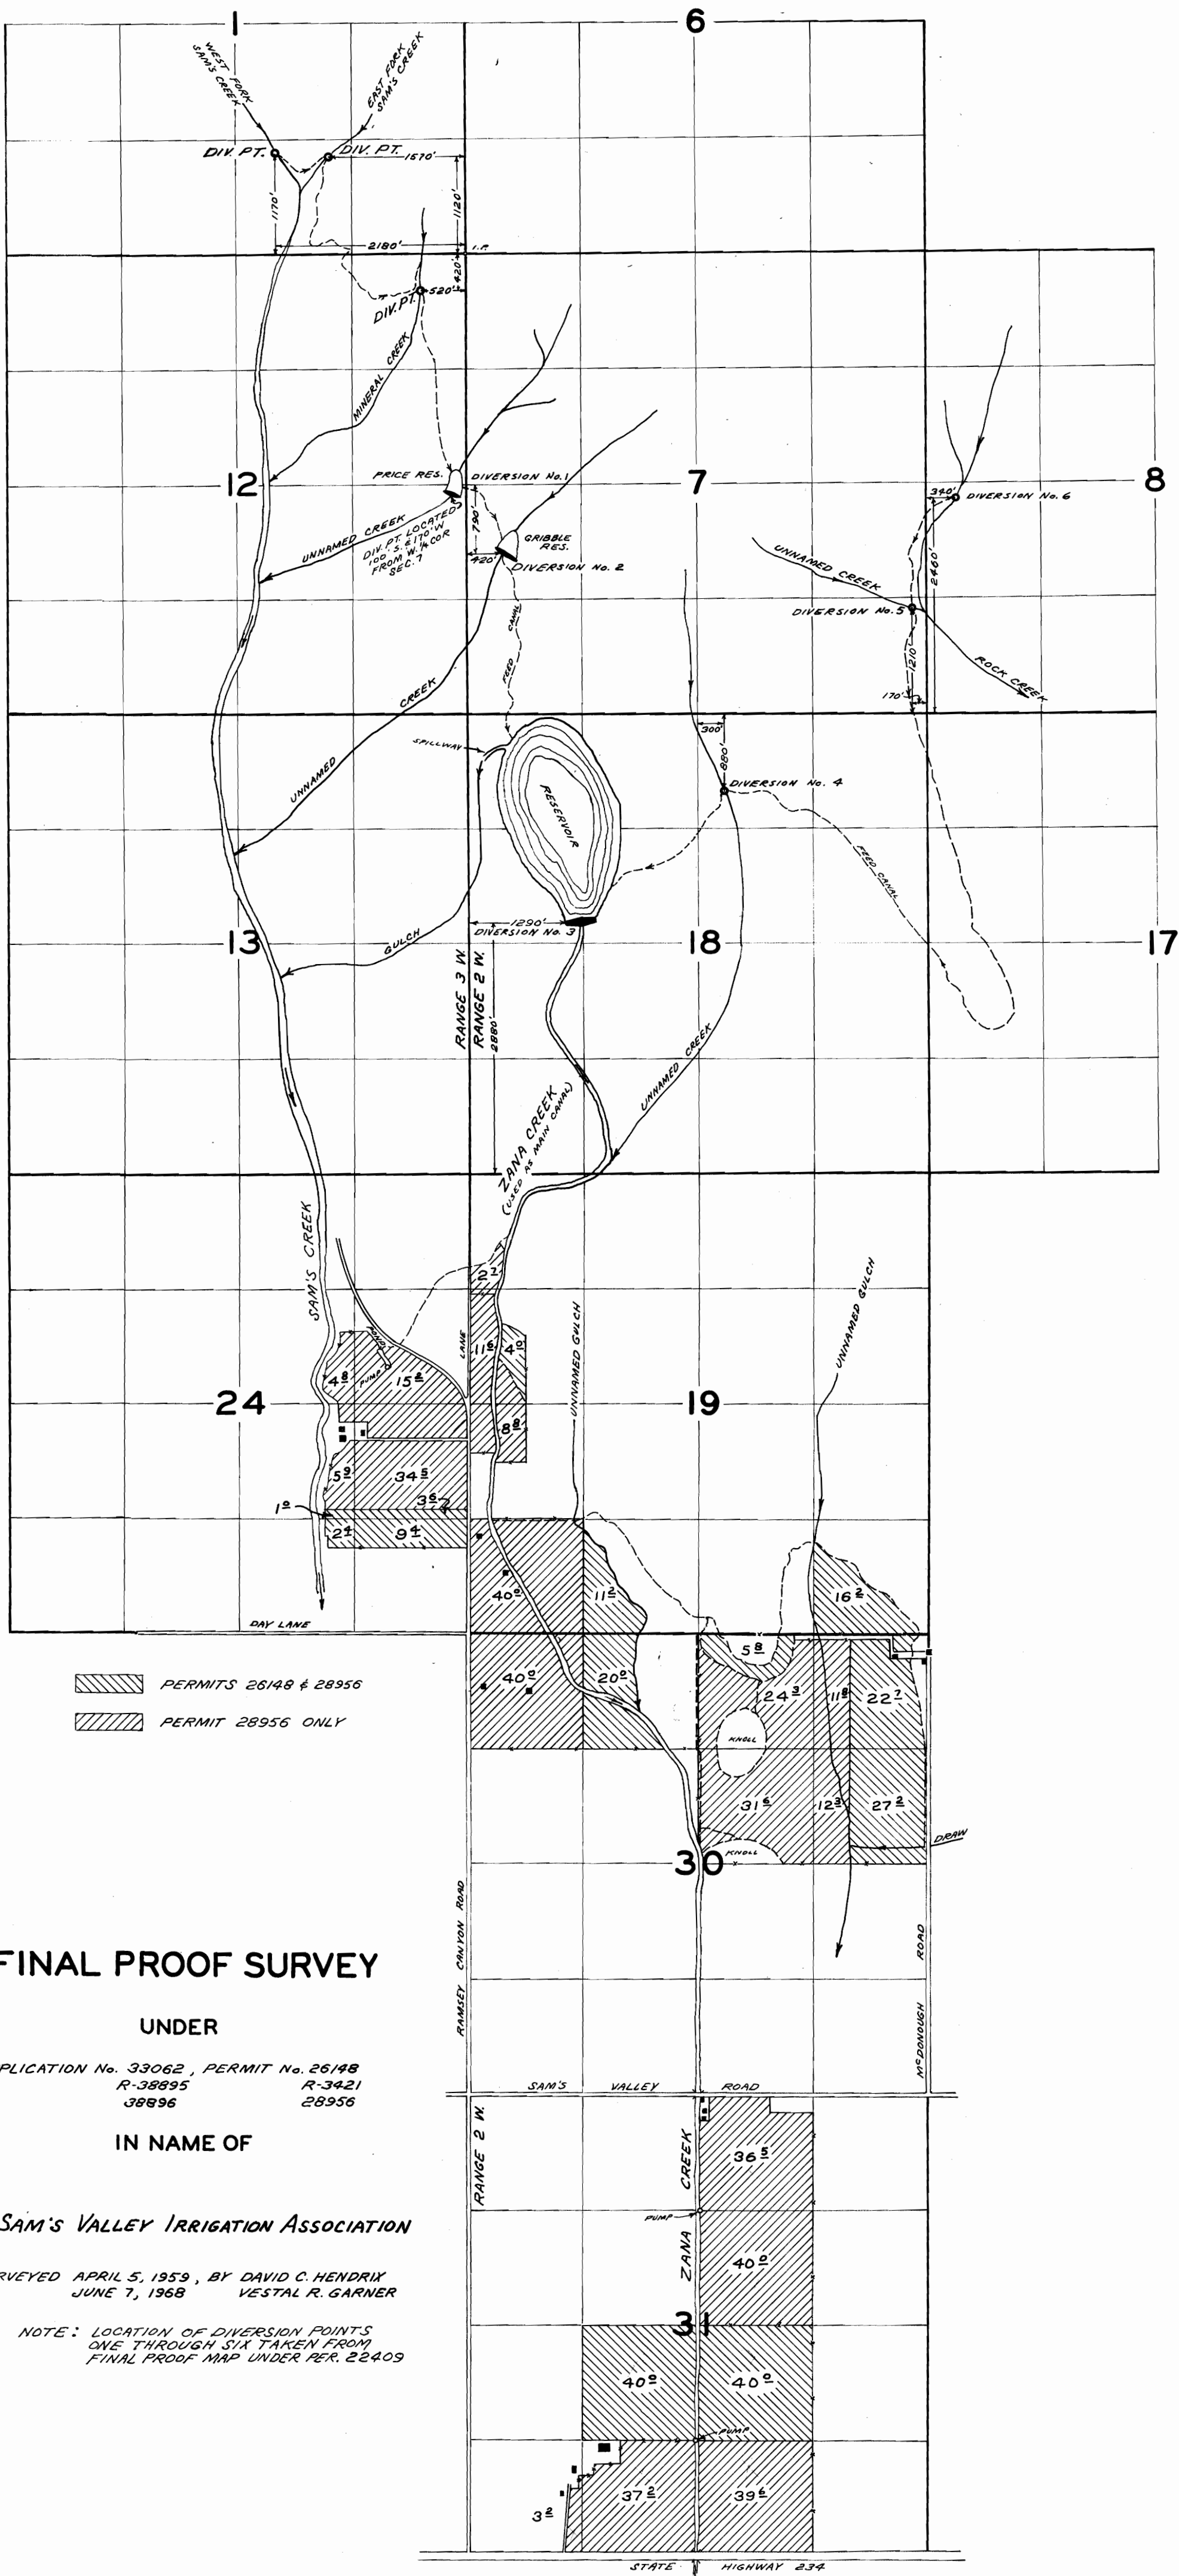

PERMITS 26148 & 28956
PERMIT 28956 ONLY

FINAL PROOF SURVEY

UNDER

APPLICATION No. 33062, PERMIT No. 26148
R-38895 R-3421
38896 28956

IN NAME OF

SAM'S VALLEY IRRIGATION ASSOCIATION

SURVEYED APRIL 5, 1959, BY DAVID C. HENDRIX
JUNE 7, 1968 VESTAL R. GARNER

NOTE: LOCATION OF DIVERSION POINTS
ONE THROUGH SIX TAKEN FROM
FINAL PROOF MAP UNDER PER. 22409