


T.24S.R.7W.W.M.

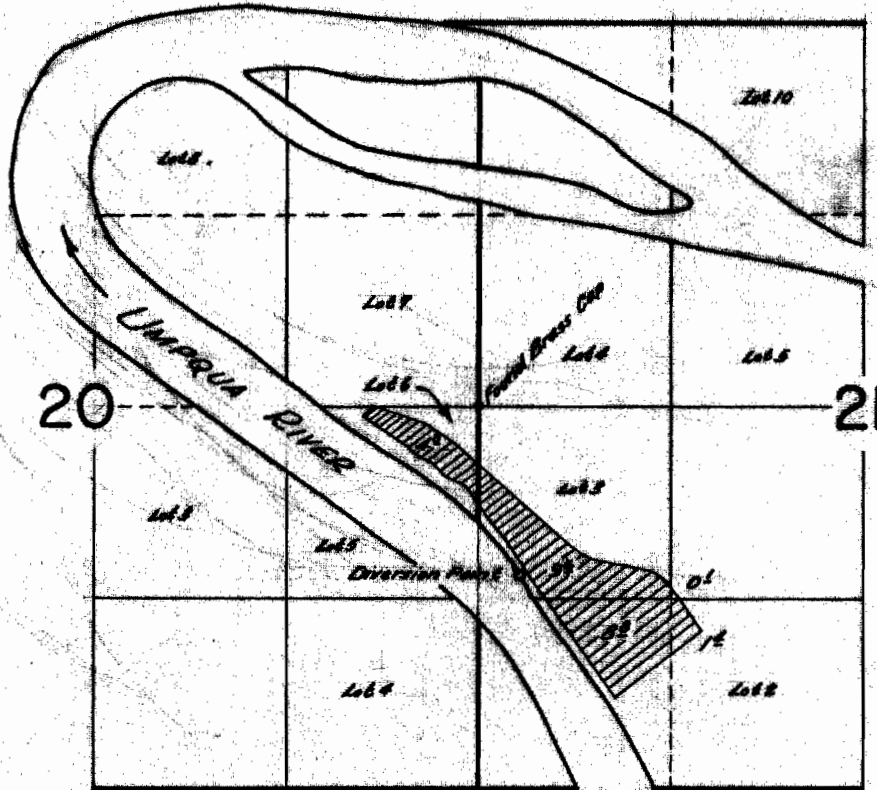

**FINAL PROOF SURVEY
UNDER**

Application No. 37634... Permit No. 28061...
IN NAME OF

Adolph Olson

Surveyed June 6... 1963, by T. Lauer