


2344 36481 P-3638
Incorrectly Represents the works described in the accompanying application
relocation of streams and other ditches in the immediate

S Wright
Sur

T. 9 S. R. 27. E. W. 3.

T. 9 S. R. 28. E

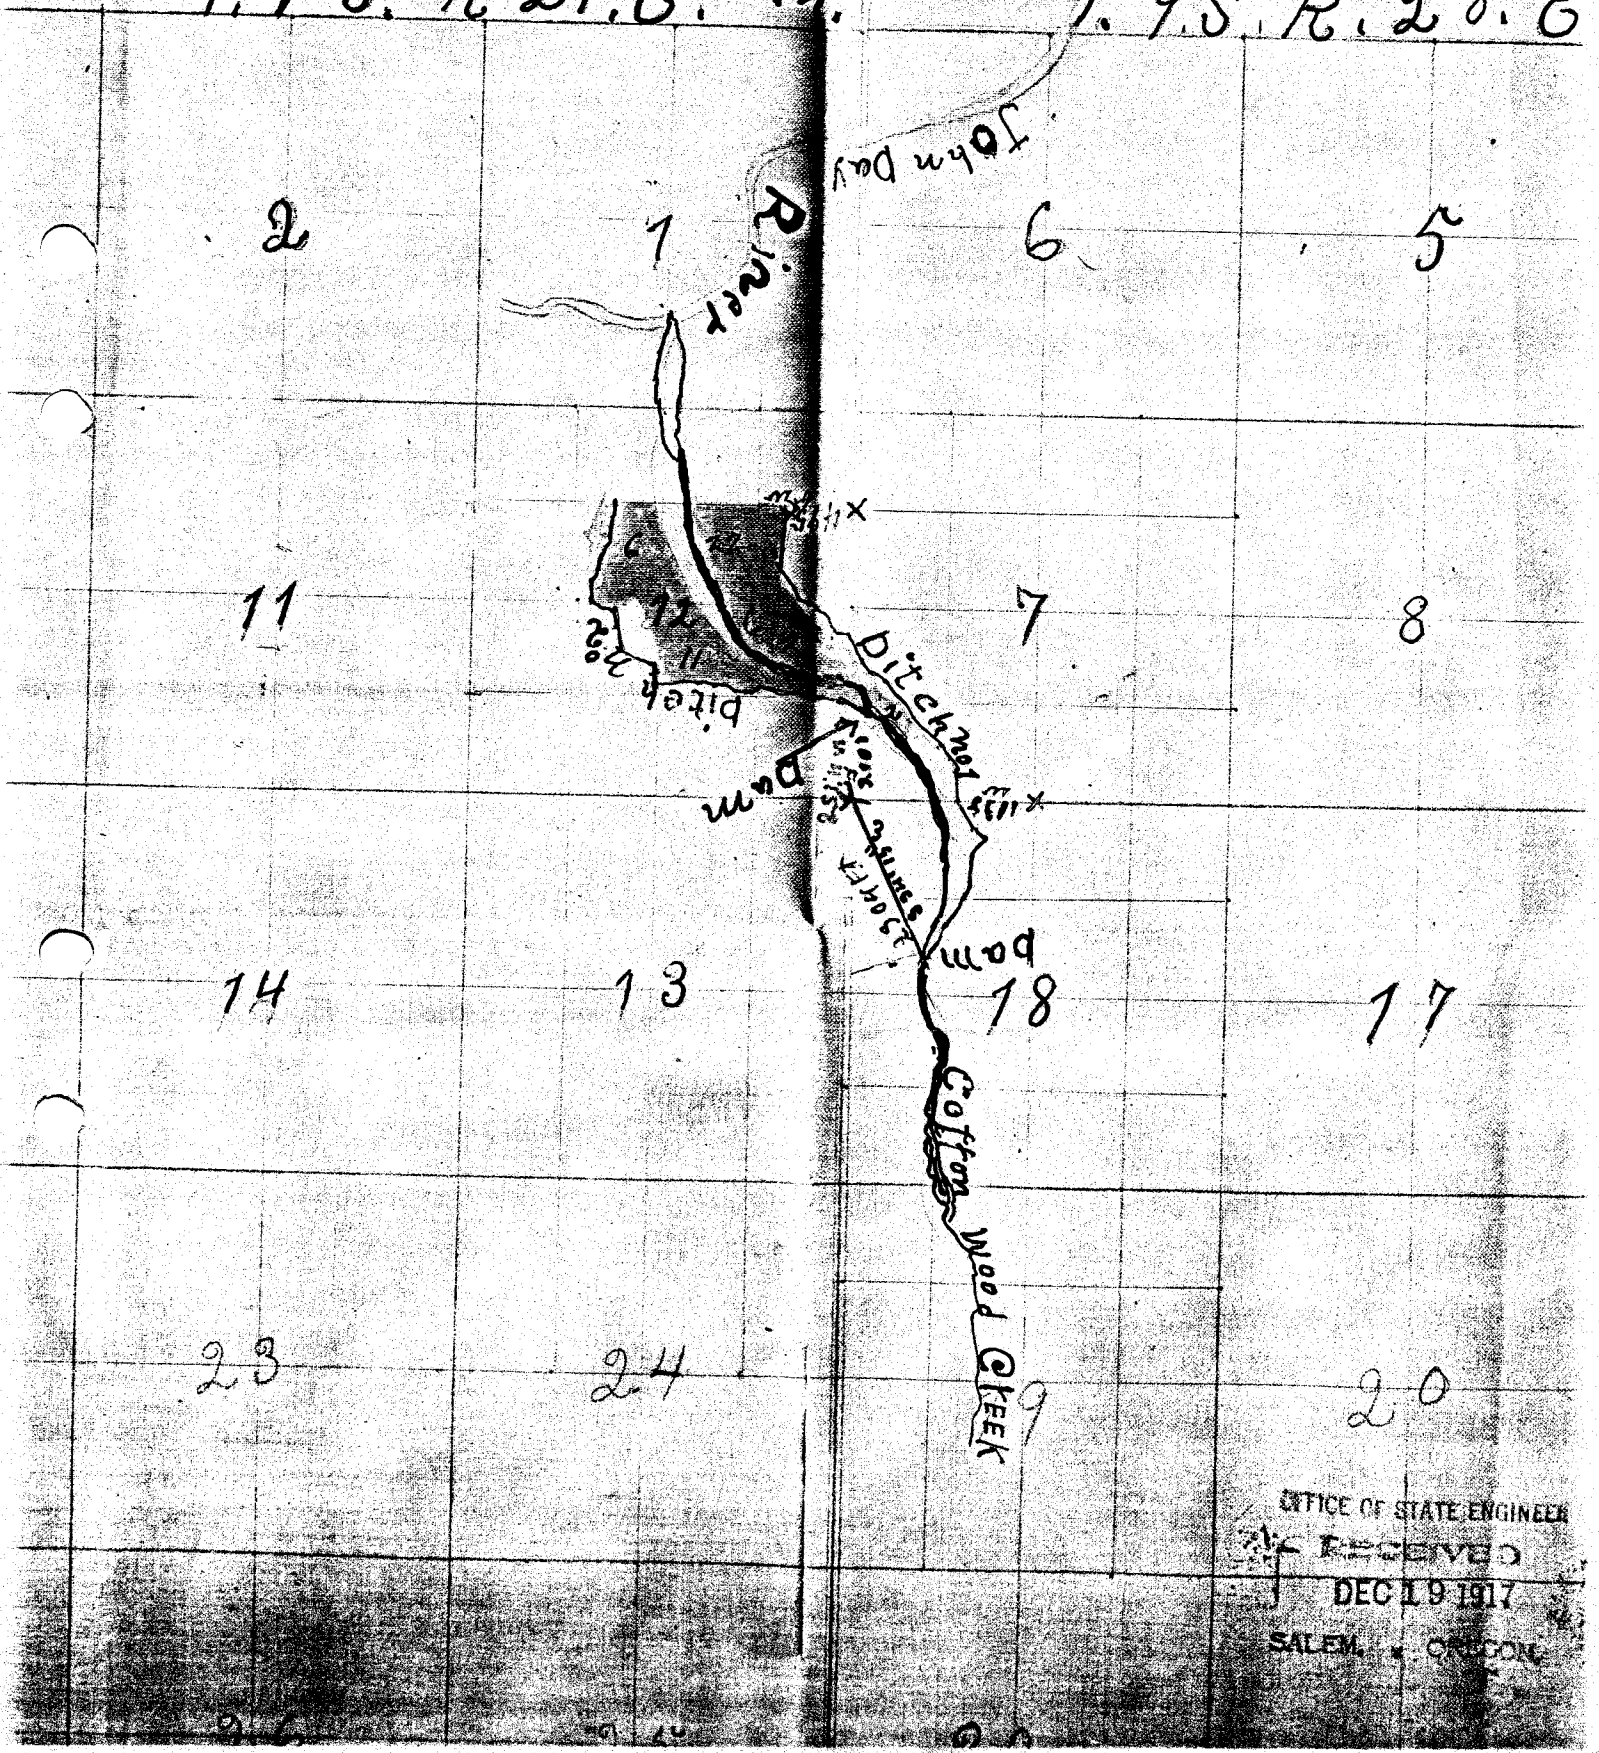

OFFICE OF STATE ENGINEER
RECEIVED
DEC 19 1917
SALEM, OREGON