


RECEIVED

SEP 29 1989

T.6S. R.3W. W.M.

WATER RESOURCES DEPT
SALEM, OREGON

MARION COUNTY

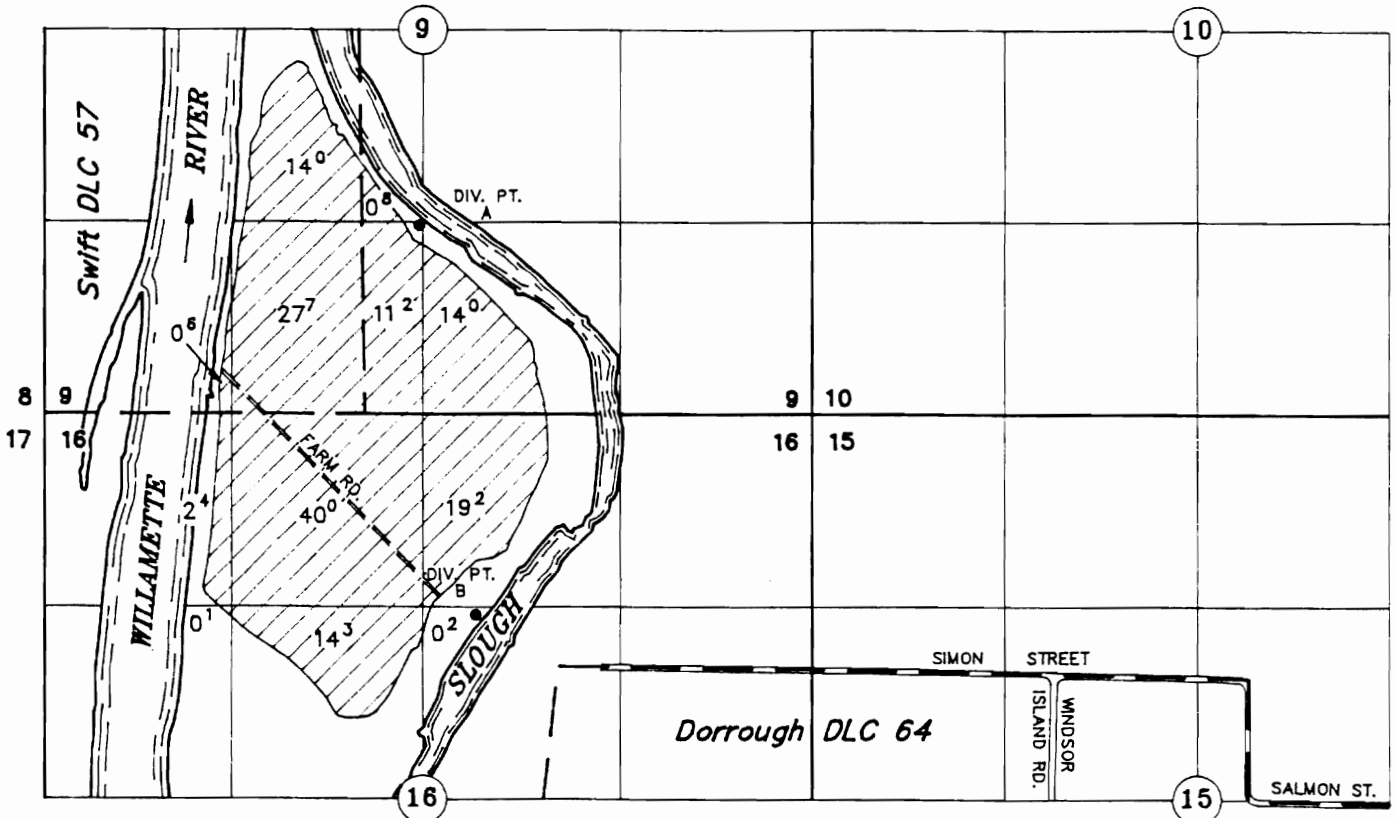

DIV. PT. A: 3110' NORTH AND 5695' WEST OF NE COR. DORROUGH DLC 64

DIV. PT. B: 437' NORTH AND 5304' WEST OF NE COR. DORROUGH DLC 64

DIVERSION POINTS A & B WERE RETIED TO THE DLC CORNER AS SHOWN. WITH THE MOVEMENT OF THE SLOUGH, THEIR LOCATIONS HAD SHIFTED FROM THEIR ORIGINAL POINTS, FOLLOWING EITHER ALONG OR PERPENDICULAR TO THE BANK OF THE SLOUGH.

TAX LOTS: 6 3W 09 00300

TAX LOTS: 6 3W 16 00300

FINAL PROOF SURVEY

UNDER

30901

24332

39956

29737

45731

34140

Application No. _____ Permit No. _____ Transfer No. T-6655

WINDSOR ROCK PRODUCTS, LLC

AUGUST 10, 1999

SCALE 1" = 1320'

NOTE: This map is for the purpose of identifying the location of water rights and has no intent to dimension or locate property ownership lines.

