


# T.12S.R.6W.W.M.

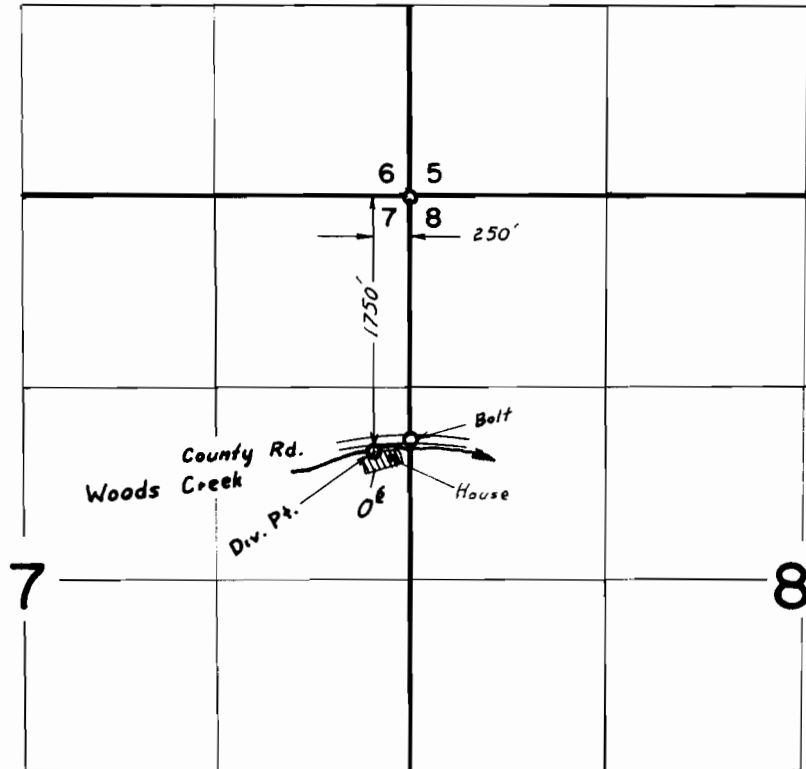

## FINAL PROOF SURVEY UNDER

Application No. 43203 . Permit No. 32297 .  
IN NAME OF

**ROBERT ELOF LARSON**

Surveyed Jun 20 . 1969, by L. E. Gould .