


T. 28S. R. 14W. W. M.

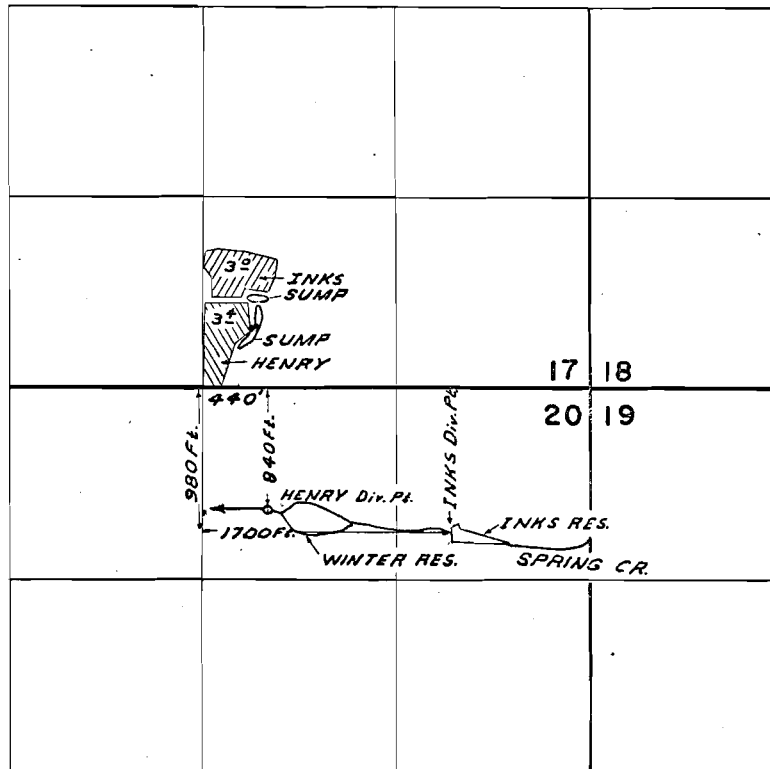

Application No. 42022

Permit No. 31526

FINAL PROOF SURVEY
UNDER

~~R-33040~~

R-2238

Application No. ~~33041~~ Permit No. ~~26134~~
IN NAME OF

H.R. INKS & R.M. HENRY

Surveyed AUG 24 1965, by L. COLEBANK