


T.29S.R.14W.W.M.

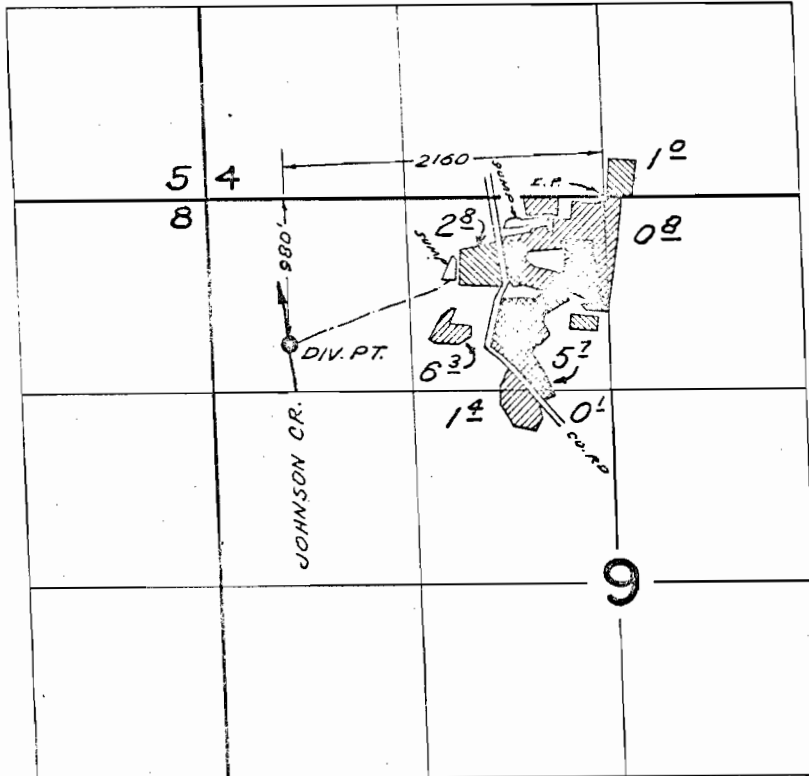

▨ PER. # 30926 - PRIMARY    ▨ PER. # 32008  
▨ PER. # 30926 - SUPPLEMENTAL


**FINAL PROOF SURVEY**  
UNDER

Application No. 41401    Permit No. 30926  
42825    32008  
IN NAME OF

RODERICK J. NIELSON

Surveyed MAY 17 1969, by W. J. RUPPERT

# T.29S.R.14W.W.M.

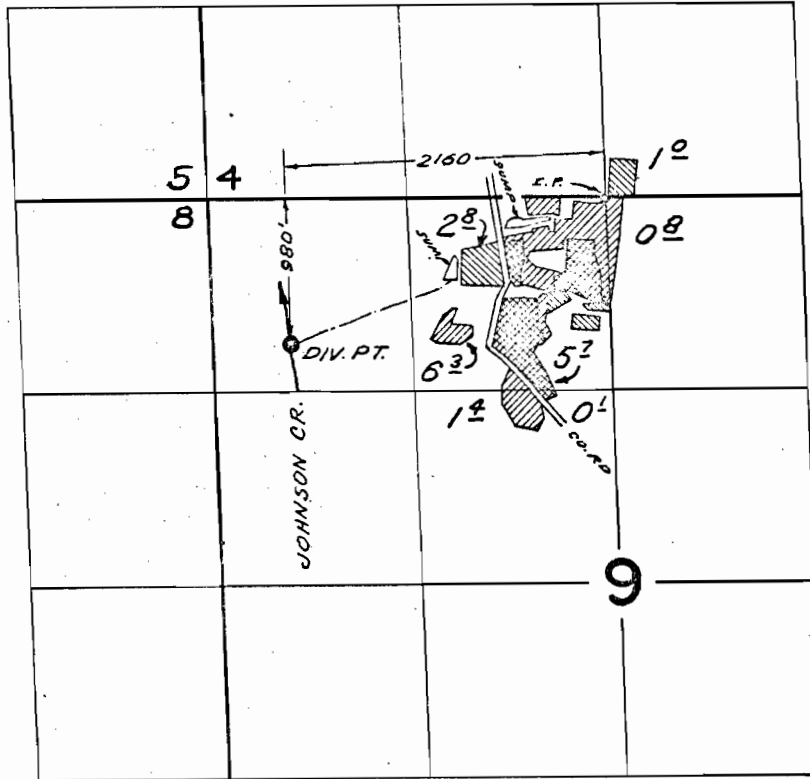

 PER. # 30926 - PRIMARY
  PER. # 32008  
 PER. # 30926 - SUPPLEMENTAL

## FINAL PROOF SURVEY UNDER

Application No. 41401 Permit No. 30926  
42825 32008  
 IN NAME OF

RODERICK J. NIELSON

Surveyed MAY 17 1969, by W. J. RUPPERT