


T.35S.R.11W. W.M.

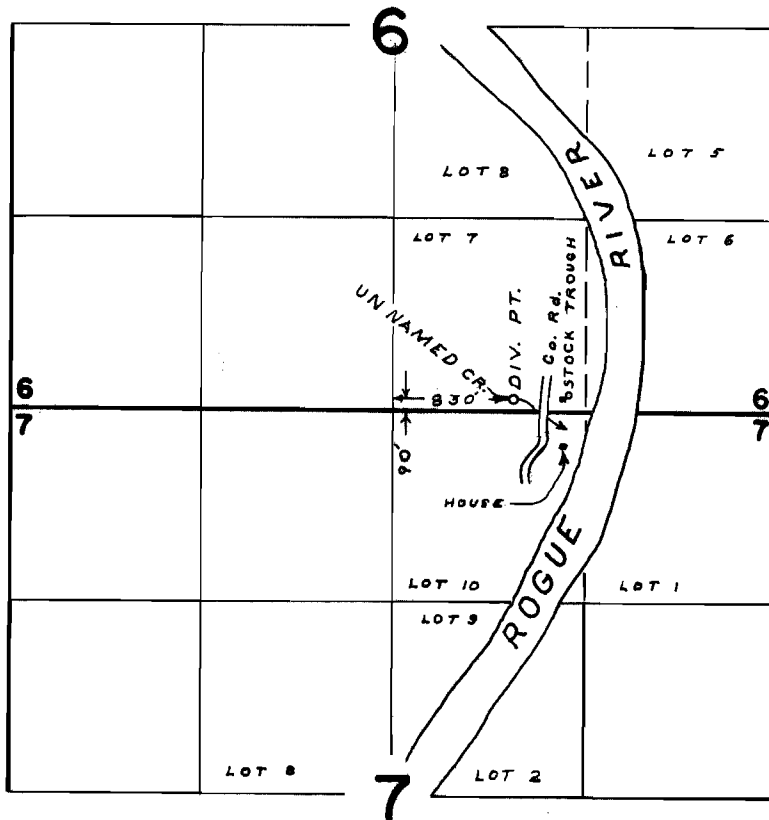

FINAL PROOF SURVEY
UNDER

Application No. 37141 Permit No. 27668
IN NAME OF

JACK W. STAMPER

Surveyed SEPT. 14, 1968, by L. E. GOULD