


T. 32 S. R. 15 W. W.M.

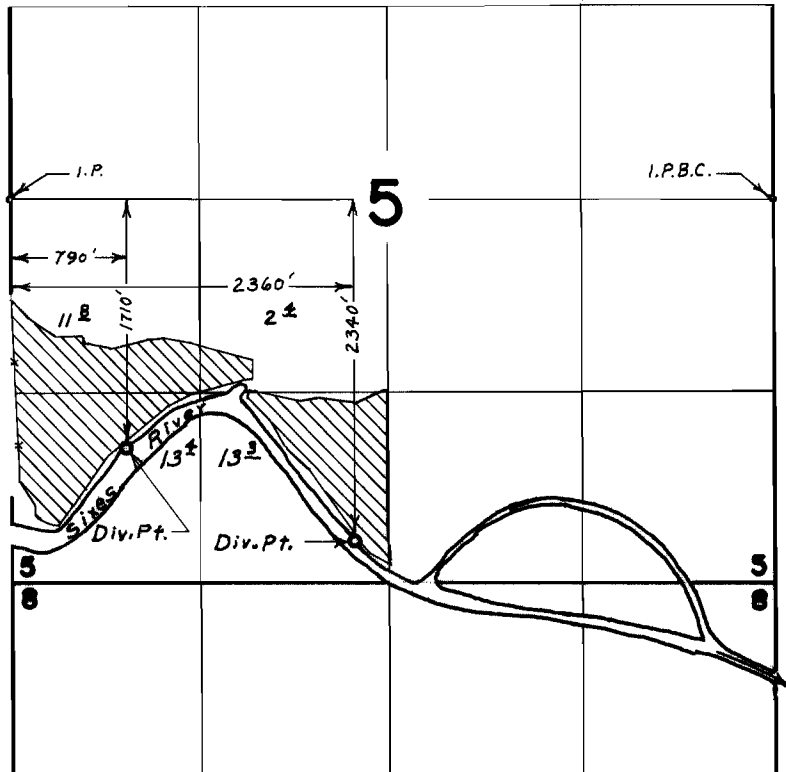

FINAL PROOF SURVEY UNDER

Application No. 39779 Permit No. 29493
IN NAME OF
VIRGIL LIBBY

Surveyed Sept. 14, 1966, by Y. Garner
May 13, 1969, by L. E. Gould