


C36506

T. 17 S. R. 12 E. W. M.

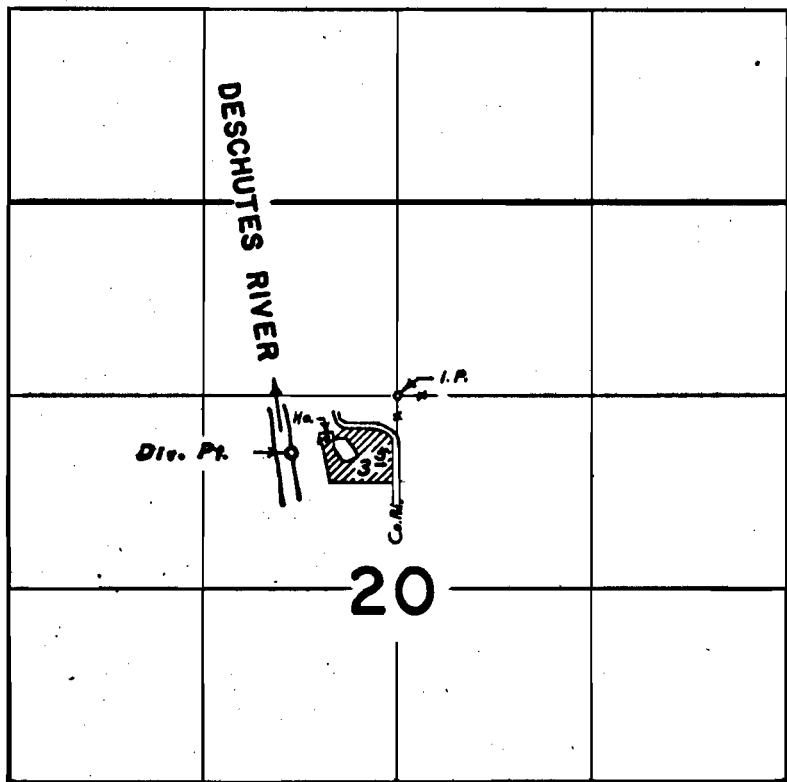

Div. Pt. located 380' S. & 720' W. from N.E. cor. S.E. & N.W. of Sec. 20

FINAL PROOF SURVEY
UNDER

Application No. 34225. Permit No. 27095...
IN NAME OF

JOHN H. & BONNIE JEAN MCGUFFEY

Surveyed Oct. 24, 1968, by W. J. Ruppert

p. 27095