


# T. 17 S. R. 11 E. W. M.

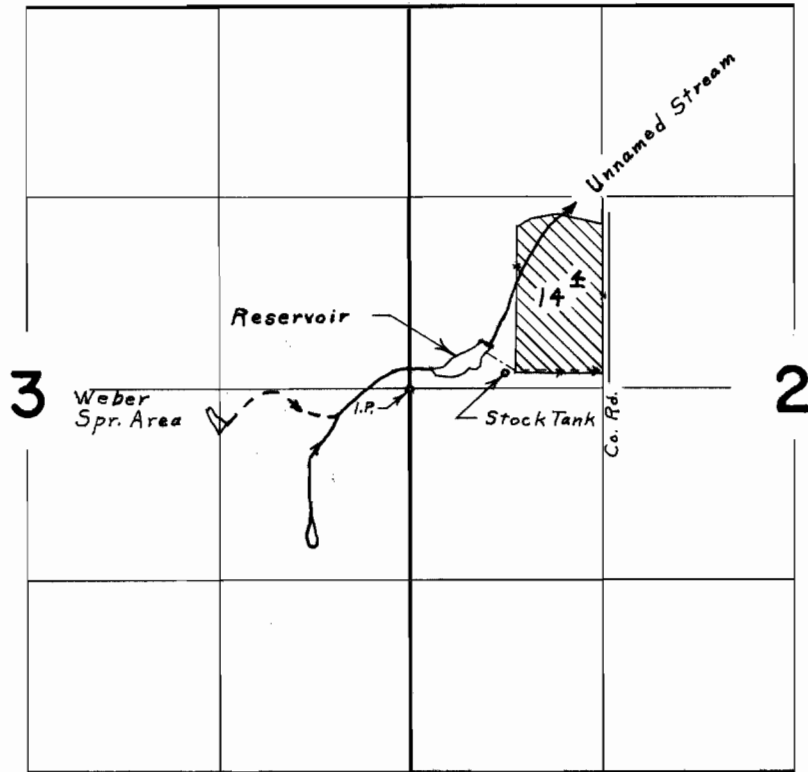

Div. Pts. located: Res. & Str., 300' N. & 550' E.; Weber Spr., 210' S. & 1330' W.  
both from W.  $\frac{1}{4}$  cor. Section 2

## FINAL PROOF SURVEY UNDER

Application No. <sup>35112</sup> R-37114. Permit No. <sup>27588</sup> R-2684.  
IN NAME OF

*DONNA E. GILL*

Surveyed Oct. 21, 1968, by W. J. Ruppert