


T. 17 S. R. 11 E. W. M.

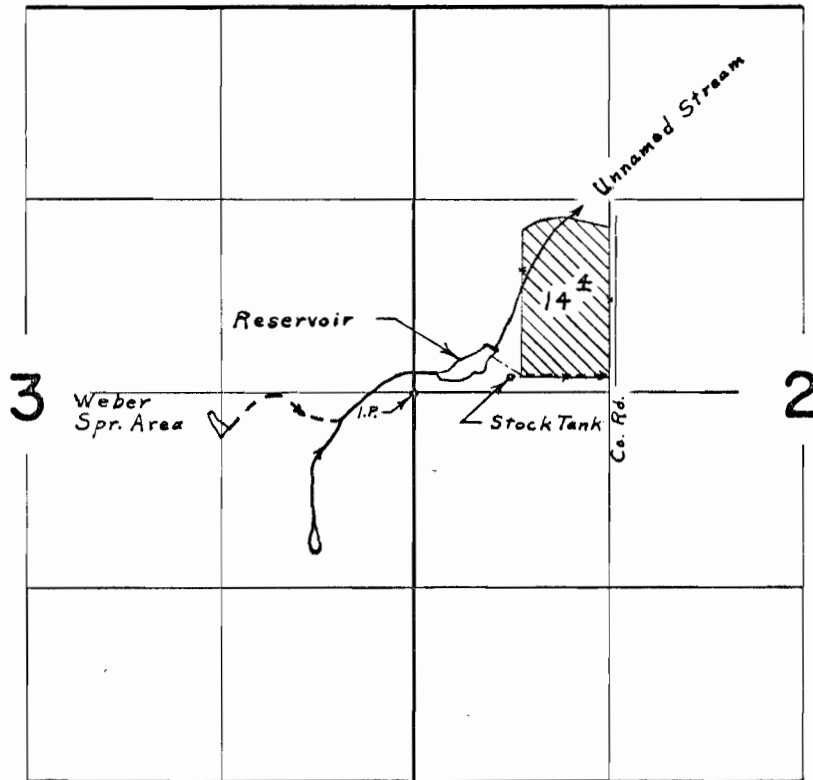

Div. Pts. located: Res. & Str., 300' N. & 550' E.; Weber Spr., 210' S. & 1330' W.
both from W. $\frac{1}{4}$ cor. Section 2

FINAL PROOF SURVEY UNDER

Application No. ³⁵¹¹² R-37114. Permit No. ²⁷⁵⁸⁸ R-2684.
IN NAME OF

DONNA E. GILL

Surveyed Oct. 21, 1968, by W. J. Ruppert