


T. 30 S. R. 5 W. W. M.

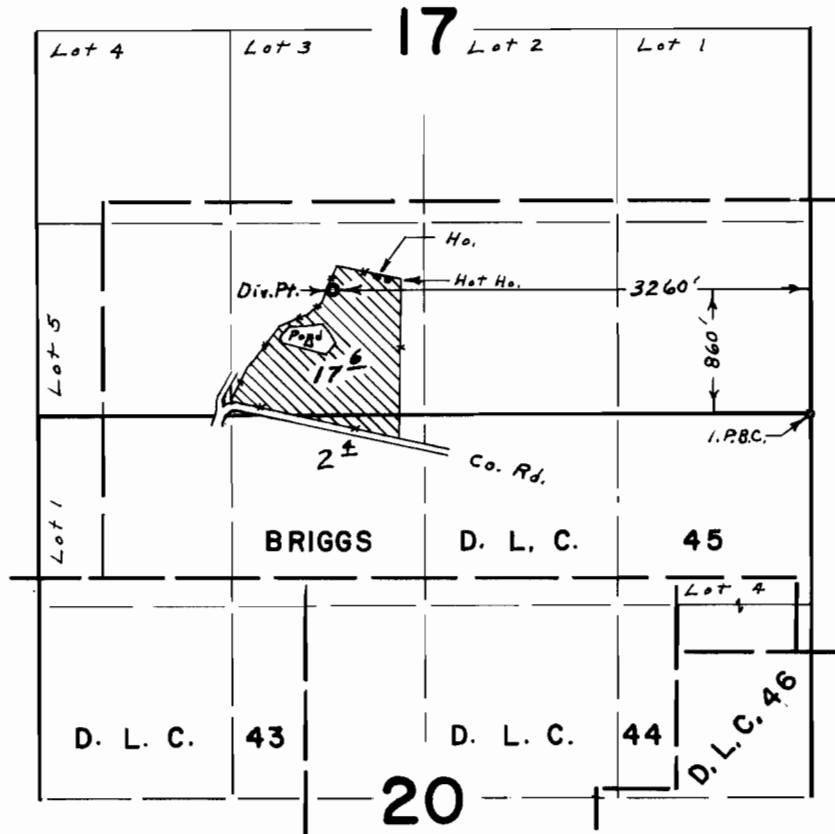

FINAL PROOF SURVEY UNDER

Application No. G-3093. Permit No. G-2889.
IN NAME OF

RICHARD D. SCOTT

Surveyed Aug. 4, 1969, by L. E. Gould