


T.28S. R.7W.W.M.

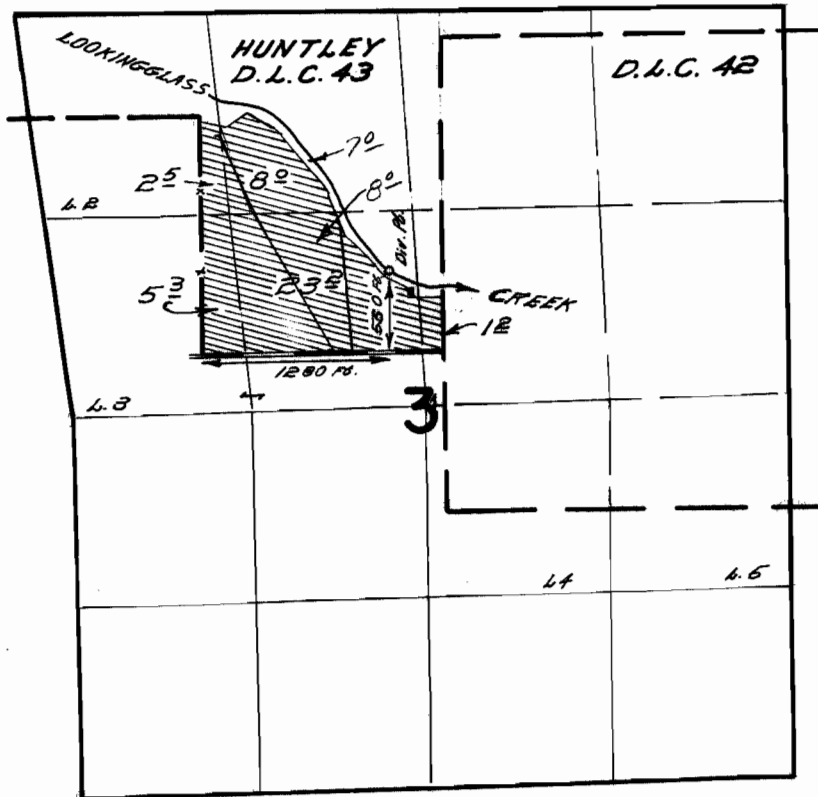

FINAL PROOF SURVEY
UNDER

Application No. 38458 Permit No. 28641
IN NAME OF

ERNEST VOORHIES

Surveyed June 6, 1967, by W.D. Ruppert
June 24, 1968