


T. 24 S. R. 30 E. W. M.

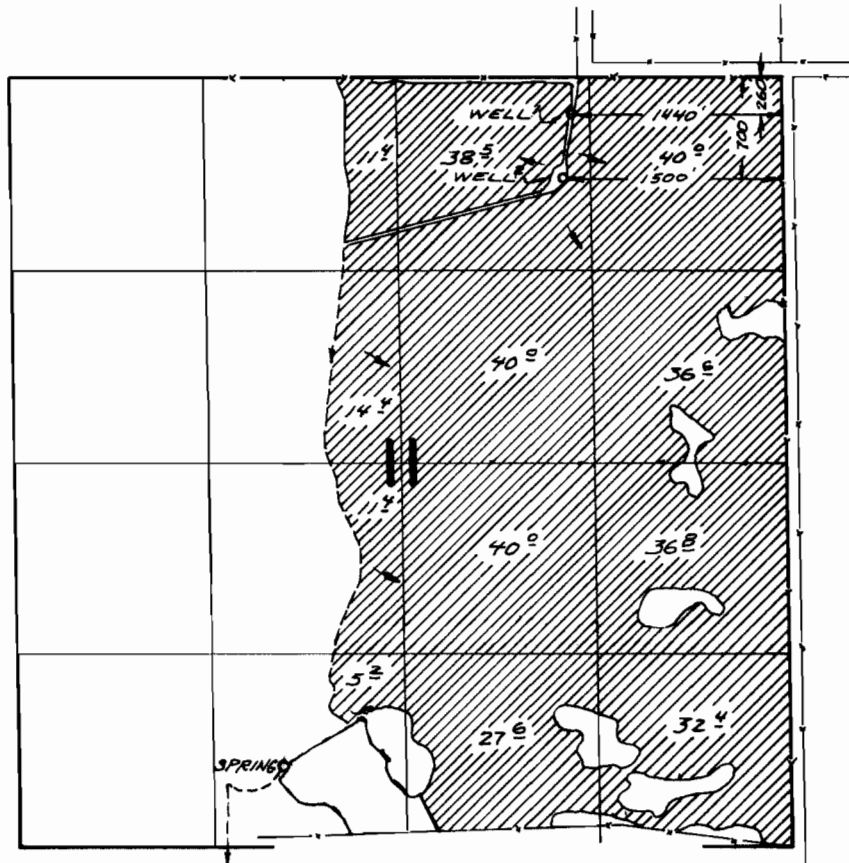

FINAL PROOF SURVEY
UNDER

Application No. G-2297. Permit No. G-2118. 
IN NAME OF

LYLE, STANTON, & WESLEY TYLER

Surveyed *SEPT. 16 1968*, by *V. GARNER*