


T.35S. R.33E. W.M.

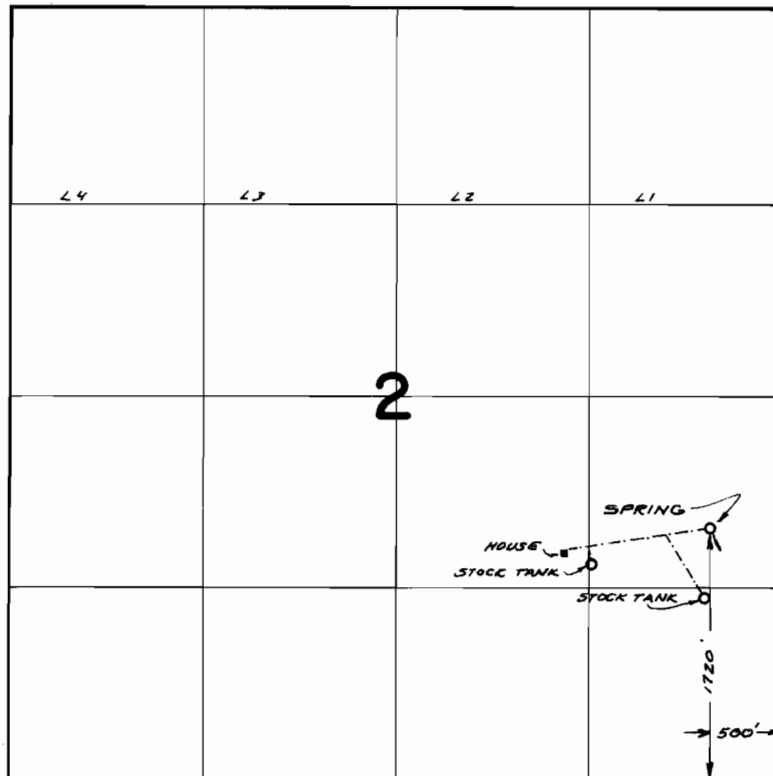

FINAL PROOF SURVEY
UNDER

Application No. 40449 Permit No. 30151
IN NAME OF

BRUCE BERRINGTON

Surveyed Sept 10 1968, by V. Garner