


T.37&38S.R.7W.W.M.

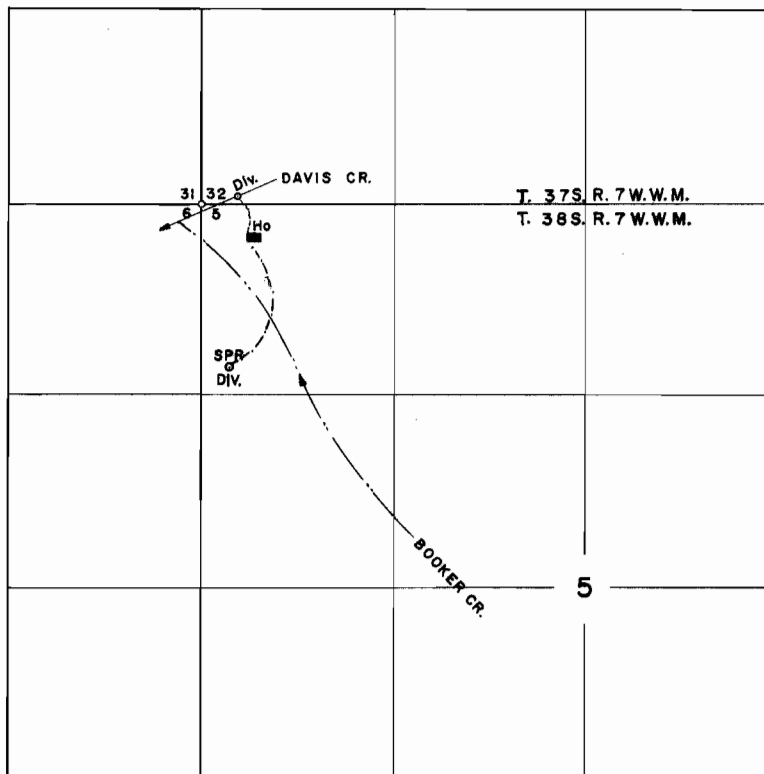

Spring Div. located 1100' S. & 200' E. from the N.W. Cor. Sec. 5, Twp. 38S. R. 7W.W.M.
Davis Cr. Div. located 60' N. & 250' E. from the S.W. Cor. Sec. 32, Twp. 37S. R. 7W.W.M.

FINAL PROOF SURVEY
UNDER

Application No. 39062 Permit No. 29090
IN NAME OF

WILLIAM W. BOOKER

Surveyed OCT. 2 1968, by R.B. Steimer