


G-2475
36514

T.31S. R.8E. W.M.

Big Spring
Ck. well

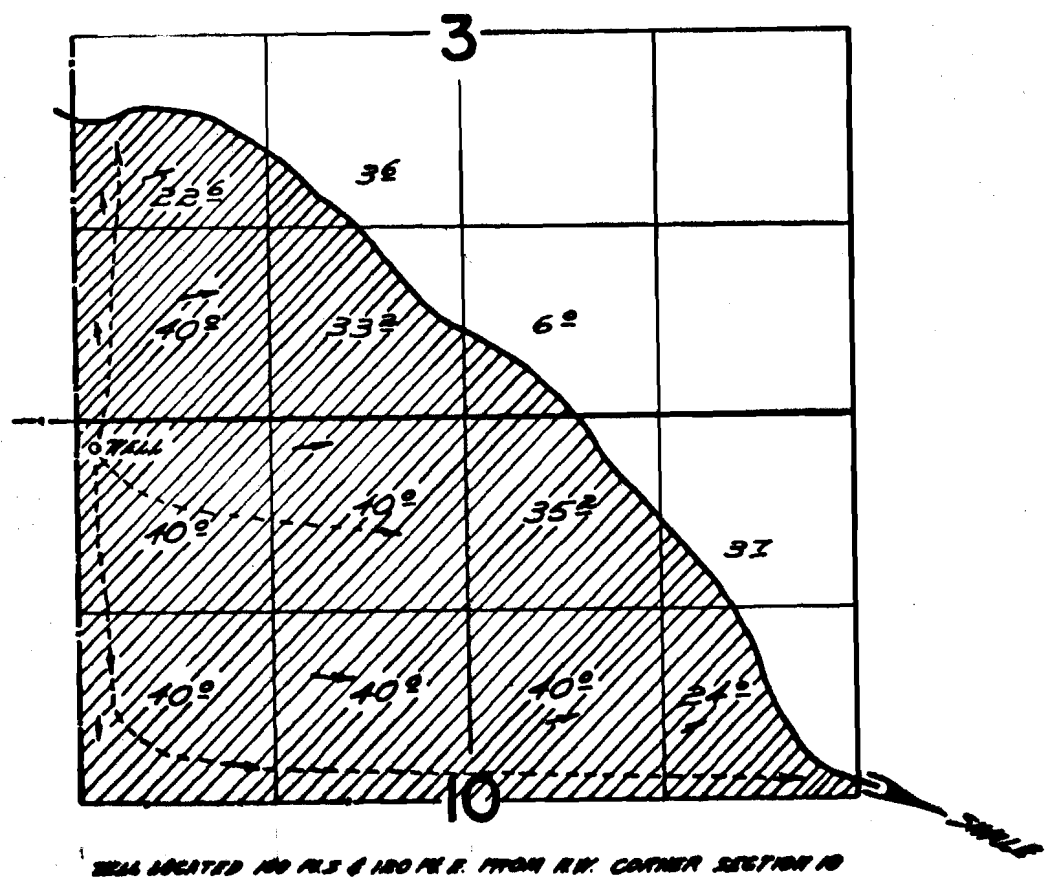

WELL LOCATED 100 FEET S 100 FEET FROM NW CORNER SECTION 10

FINAL PROOF SURVEY UNDER

Application No. G-2670... Permit No. G-2475
IN NAME OF

DONOVAN L. NICOL

Surveyed August 28 1968, by W. V. Rogers