


# T. 40 S. R. 19 E. W.M.

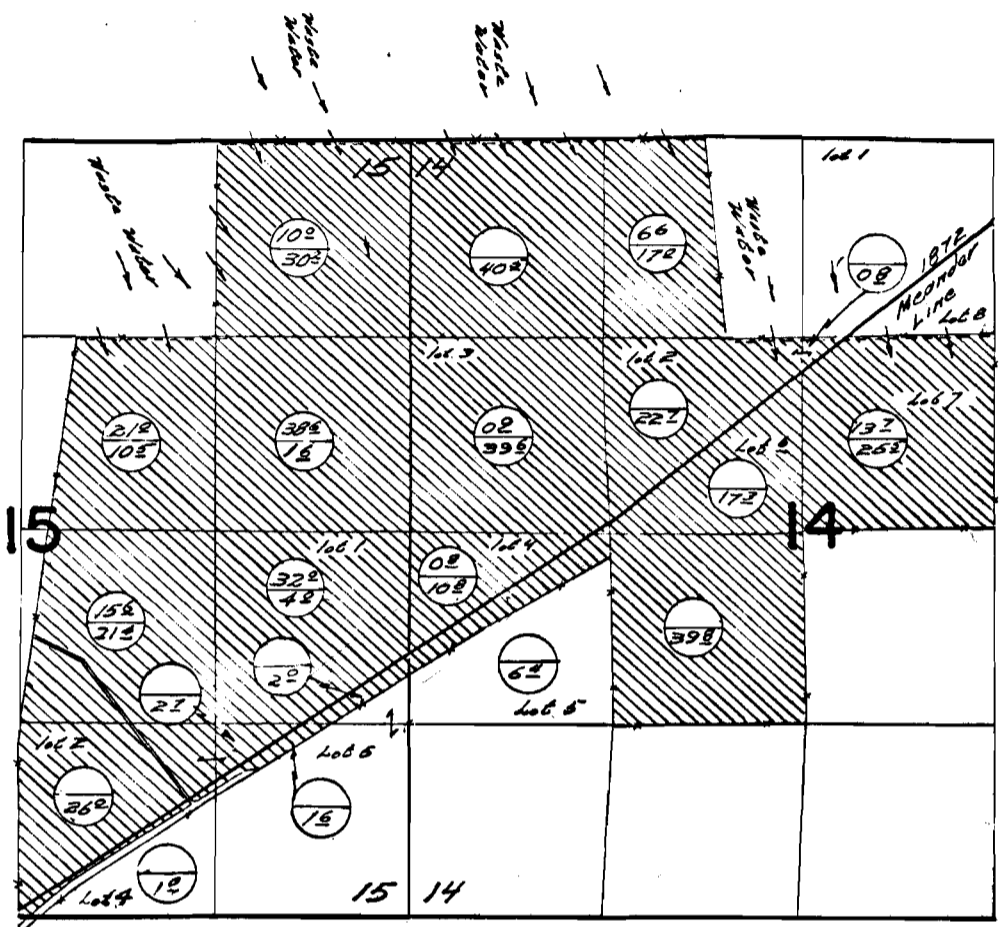


 OLD RIGHTS  
 PRIMARY

## FINAL PROOF SURVEY UNDER

Application No. 34011. Permit No. P27093  
 IN NAME OF

ED & MILDRED GARRETT

Surveyed Sept. 16 1964, by R. Jackson

40-19 ✓

20A  
 1964-F