


T. 23 S. R. 1 E. W. M.

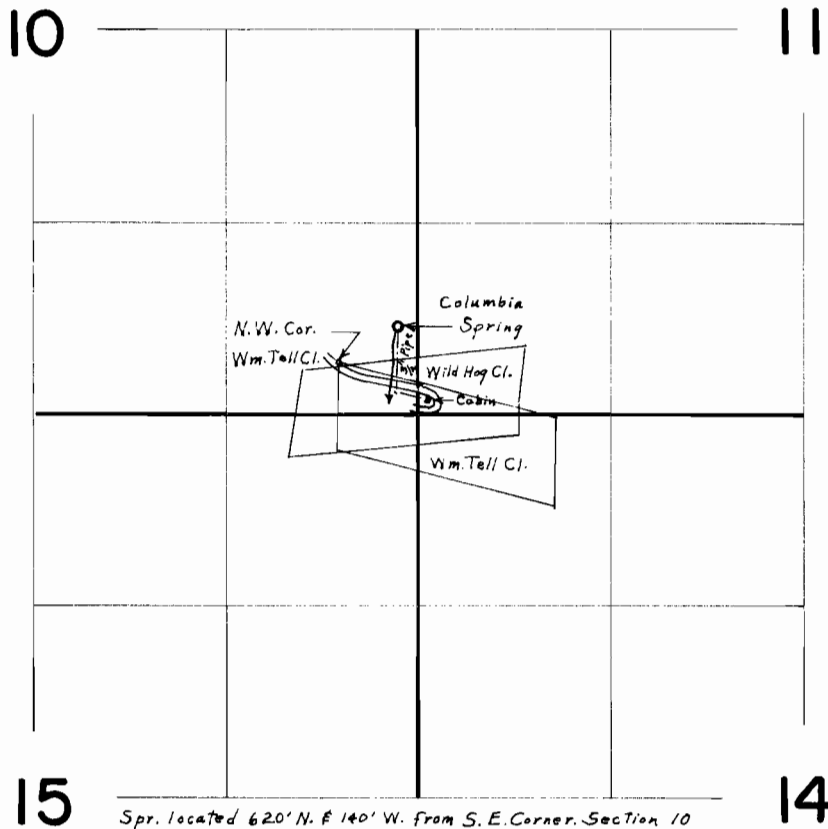

FINAL PROOF SURVEY
UNDER

Application No. 35055 Permit No. 27700
IN NAME OF
RAY E. NELSON

Surveyed Oct. 9, 1968, by L. E. Gould