


T.11 S. R. 9 W. W.M.

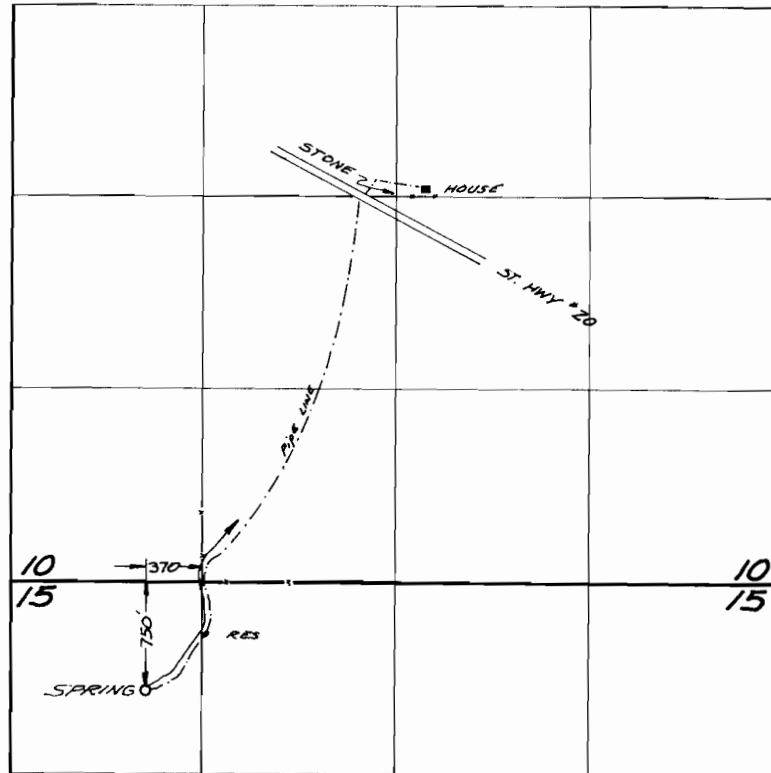

**FINAL PROOF SURVEY**  
UNDER

Application No. 37797 Permit No. 28196  
IN NAME OF

WM. R. and MARION S. McNAIR

Surveyed Oct. 7, 1968, by V. Garner