


# T. 19 S. R. 1 W. W. M.

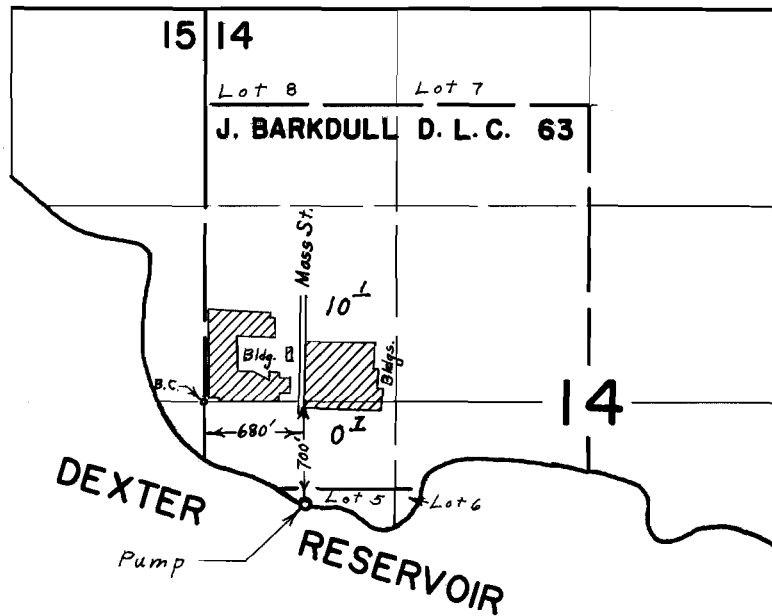

## FINAL PROOF SURVEY UNDER

Application No. 40155... Permit No. 29753..  
IN NAME OF

LOWELL SCHOOL DISTRICT NO. 71

Surveyed Nov. 6, 1968, by W. J. Ruppert