


# T.18&19S.R.3W.W.M.

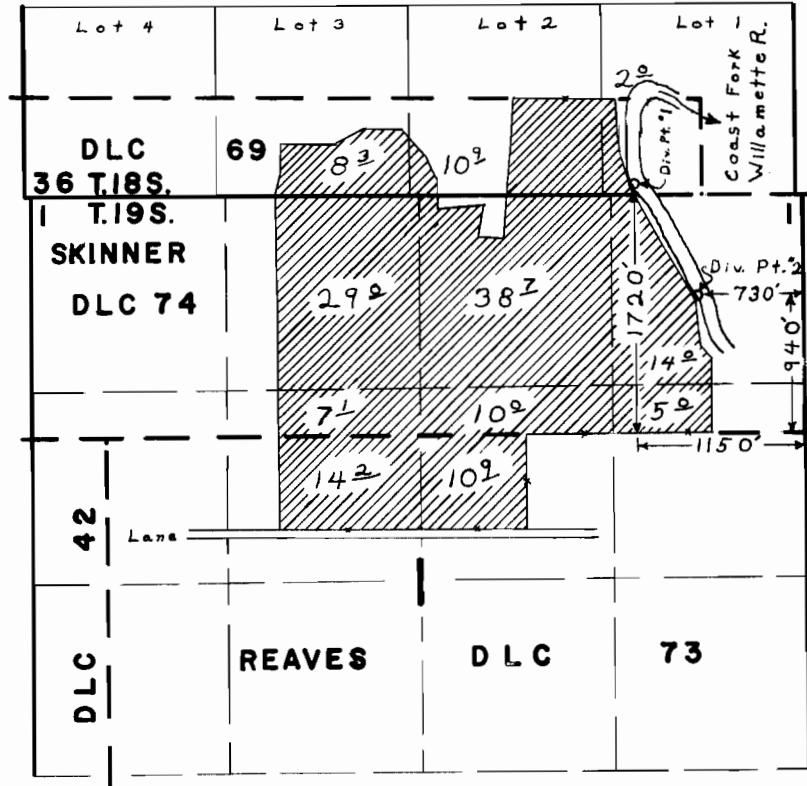

## FINAL PROOF SURVEY UNDER

Application No. **37975** . Permit No. **28317**.....  
IN NAME OF

*CURTIS A. LLOYD*

Surveyed **OCT. 11 1968**, by **L. E. GOULD**.