


T.II S. R.IIW.W.M.

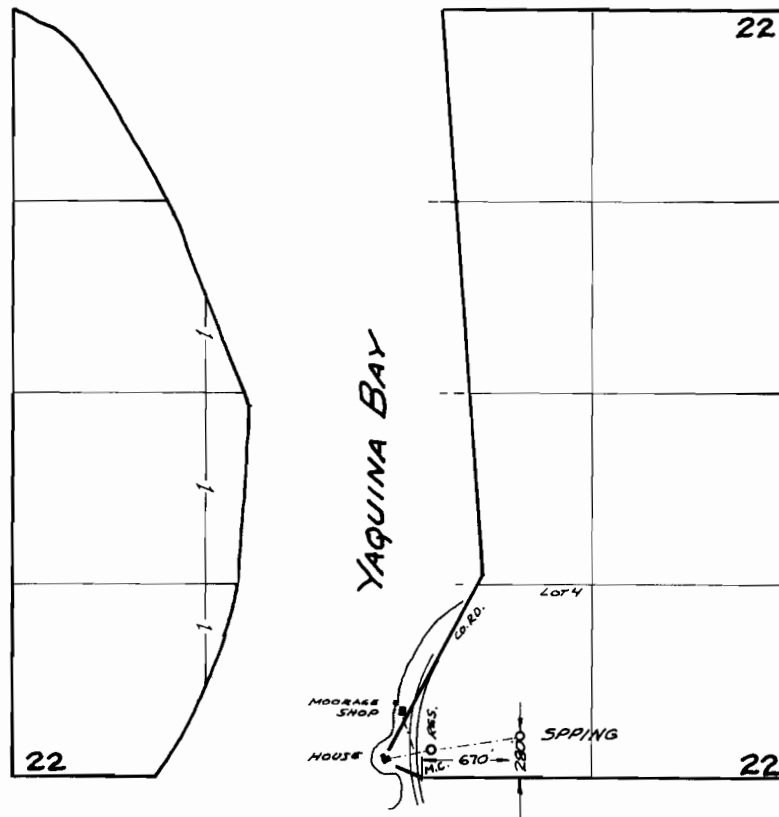

FINAL PROOF SURVEY
UNDER

Application No. 37178 Permit No. 27715
IN NAME OF

R. A. and JULIETTE CHRISTIANSEN

Surveyed Oct. 8 1968, by V. Garner