


T. 11 S. R. 11 W. W.M.

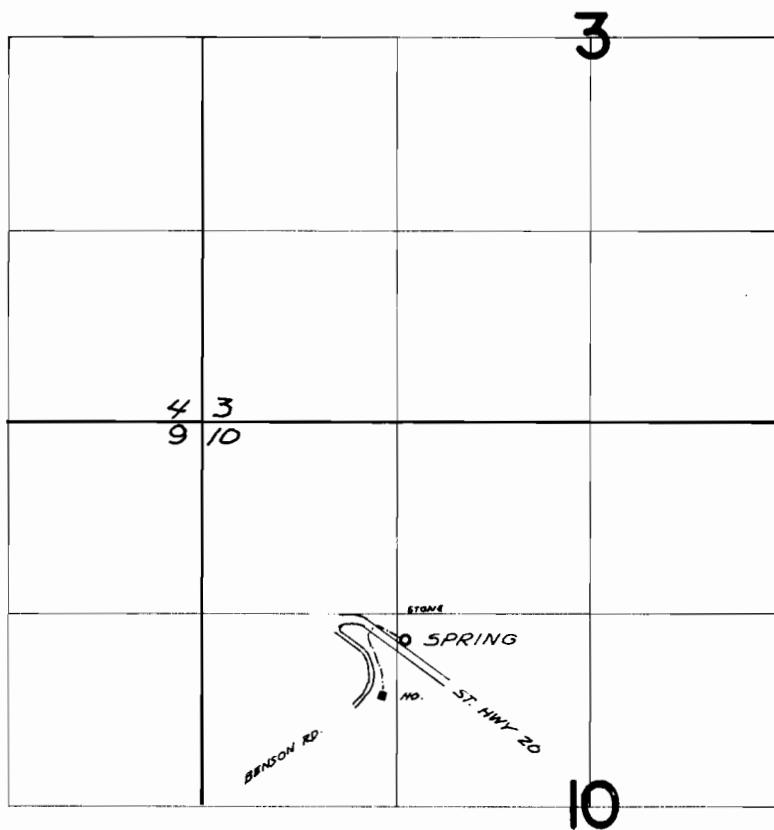

DIV. PT. LOCATED 170 FT. S. and 60 FT. E. FROM
THE NW. CORNER SE $\frac{1}{4}$ NW $\frac{1}{4}$ SECTION 10

FINAL PROOF SURVEY
UNDER

Application No. 38986 Permit No. 29045
IN NAME OF

HAROLD W. BRADSHAW

Surveyed Oct. 9, 1968, by V. Garner