


T. 11 S. R. 11 W. W. M.

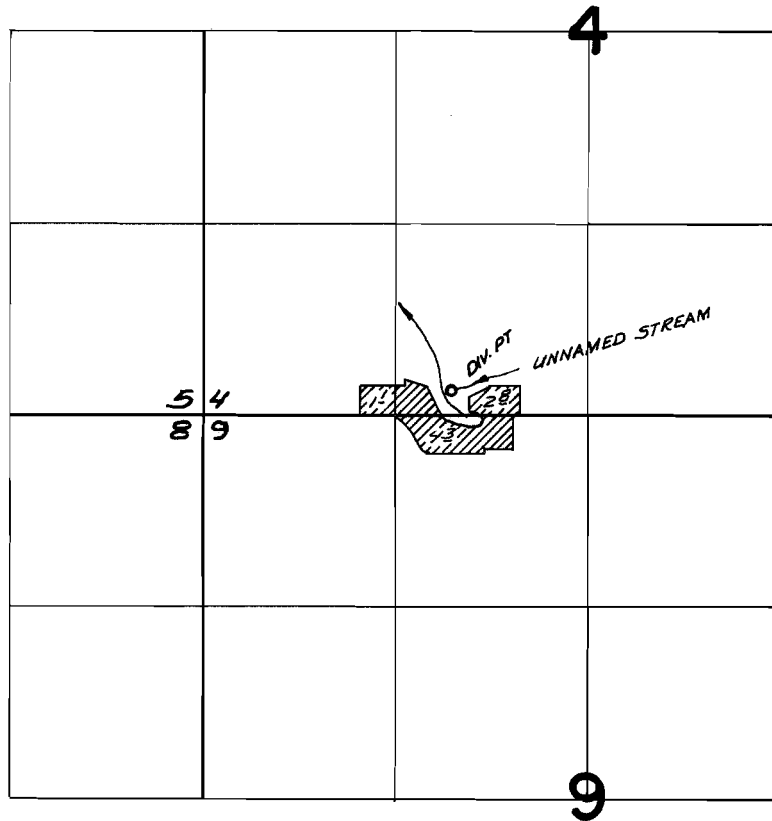

DIV. PT. LOCATED 170 FT. N & 380 FT. E FROM THE SW COR
SE $\frac{1}{4}$ SW $\frac{1}{4}$ OF SECTION 4

FINAL PROOF SURVEY
UNDER

Application No. 40580 Permit No. 30235
IN NAME OF

EUREKA CEMETERY ASSOCIATION

Surveyed OCT. 9, 1968, by V. Gardner