


T.I.S. R.I.W. W.M.

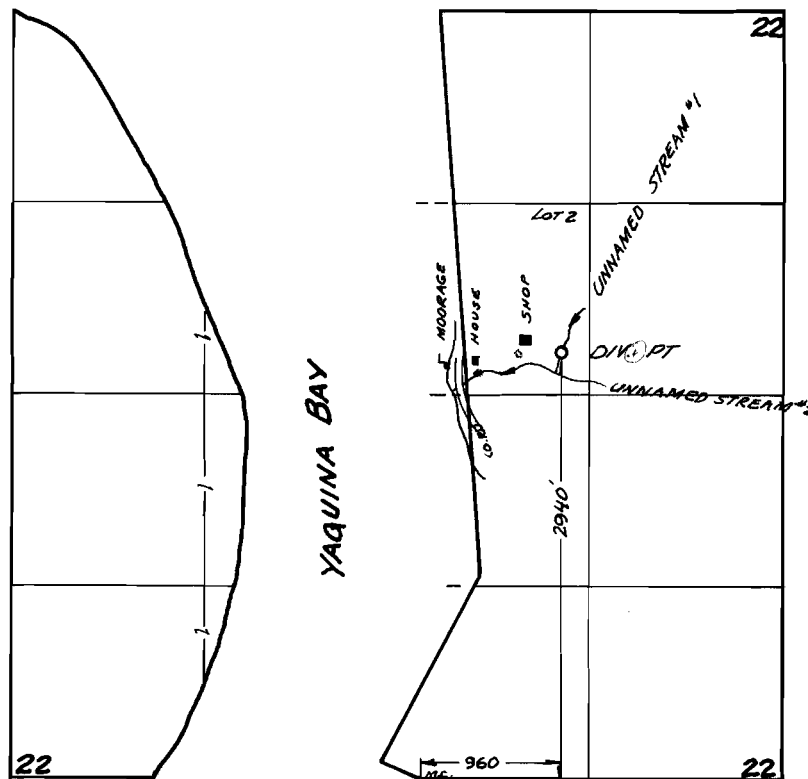

FINAL PROOF SURVEY
UNDER

Application No. 40695 Permit No. 30313
IN NAME OF

ROY L. and VERA SAWYER

Surveyed Oct. 8 1968, by V. Gardner