


T.11S.R.10W.W.M.

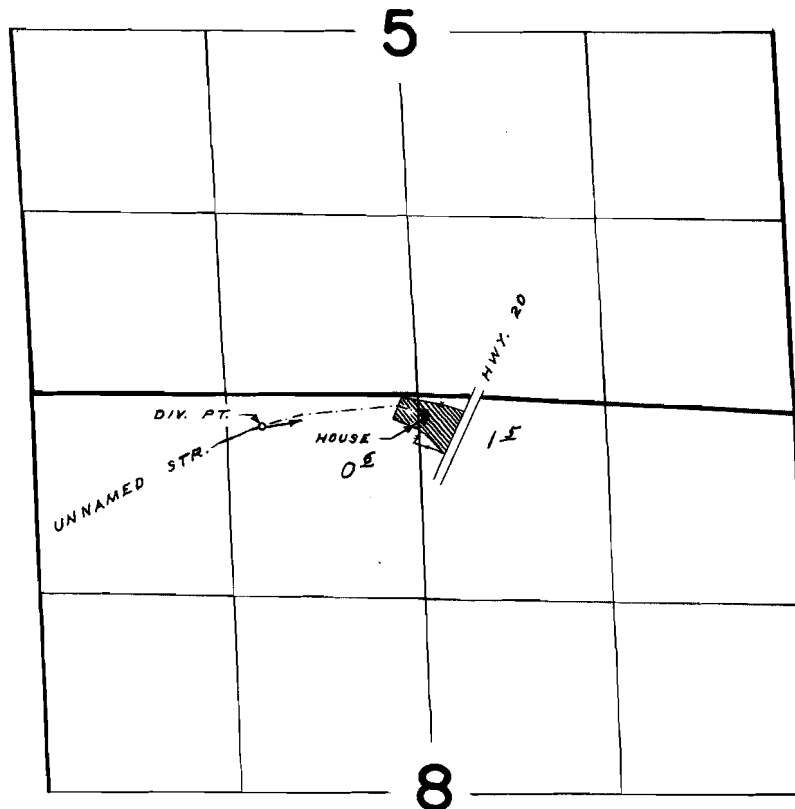

DIV. PT. LOCATED 230' S & 1060' W FROM N $\frac{1}{4}$ COR. SEC. 8

FINAL PROOF SURVEY
UNDER

Application No. 40922 Permit No. 30497
IN NAME OF

GLENN LYONS

Surveyed OCT. 2 1968, by W. J. RUPPERT