


T.6S.R.10W.W.M.

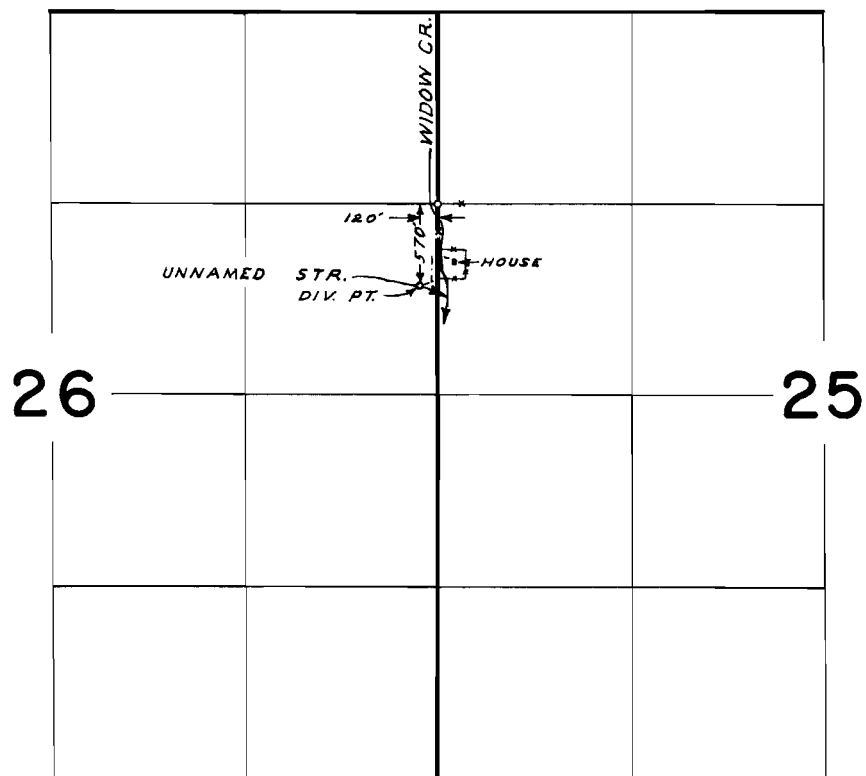

FINAL PROOF SURVEY
UNDER

Application No. **41568** Permit No. **30746**
IN NAME OF

MANDEVILLE H. MANN

Surveyed **OCT. 1**, 1968, by **W. J. RUPPERT**