


T.I.S. R.I.W. W.M.

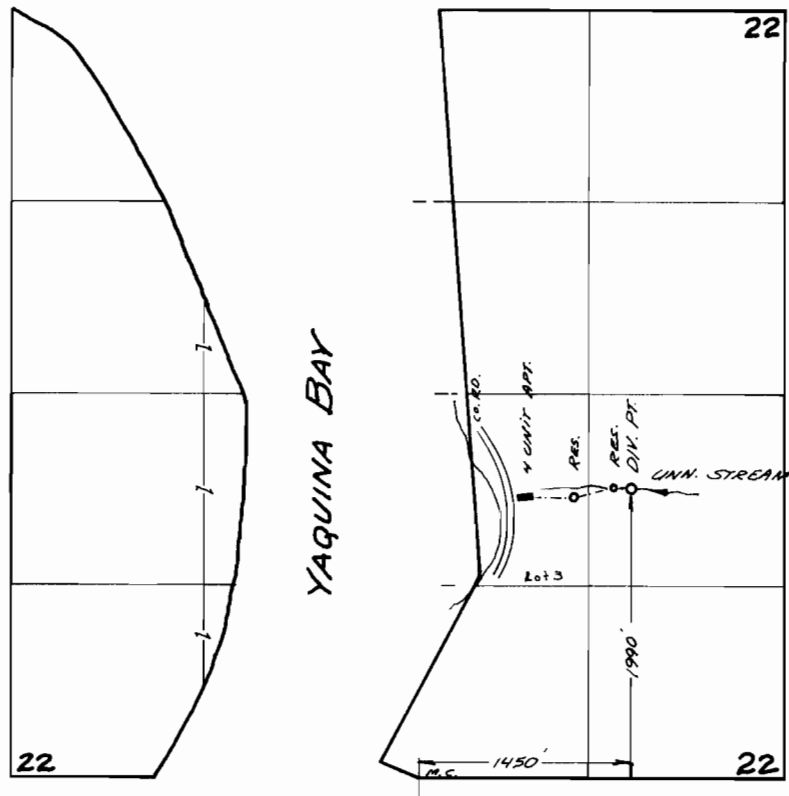

FINAL PROOF SURVEY
UNDER

Application No. 42868 Permit No. 32039
IN NAME OF

R.C. YARBROUGH

Surveyed Oct. 8, 1968, by V. Garner