


T.41S. R.42E.W.M.

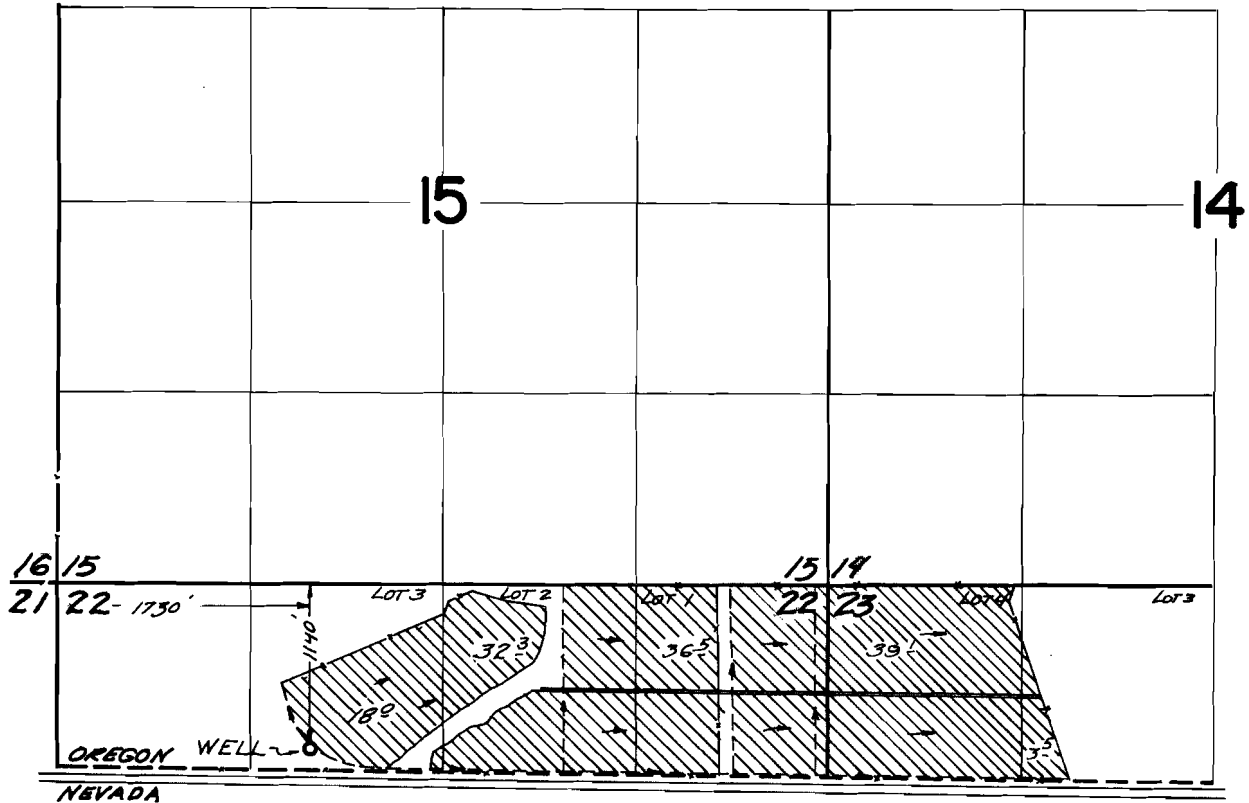

FINAL PROOF SURVEY
UNDER

Application No. G-2004 Permit No. G-1842
IN NAME OF

CAMPBELLS LUCKY SEVEN RANCH

Surveyed Oct. 24 1968, by V. Garner

1968-F