


# T. 29 S. R. 44 E. W.M.

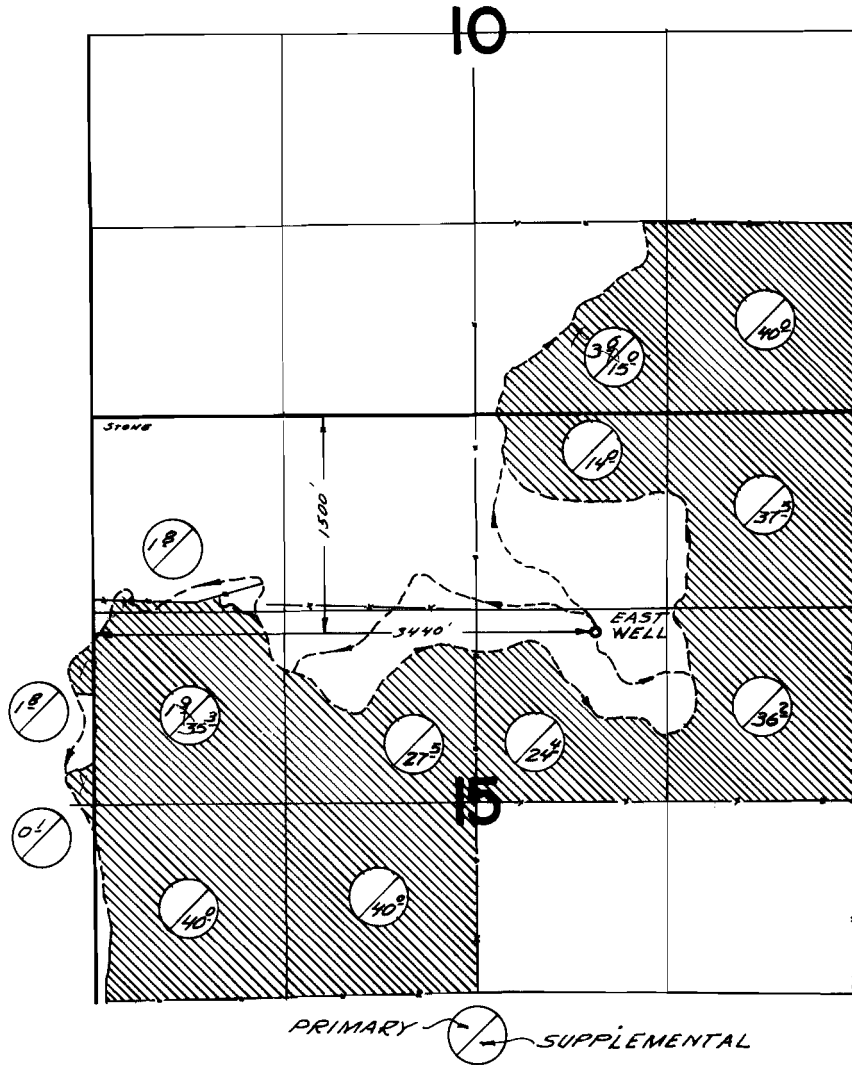

## FINAL PROOF SURVEY UNDER

Application No. G-2012 Permit No. G-1918  
IN NAME OF

*ANAWALT RANCH & CATTLE CO.*

Surveyed Oct. 28, 1968, by *V. Garner*