


T.36S. R.40E. W.M.

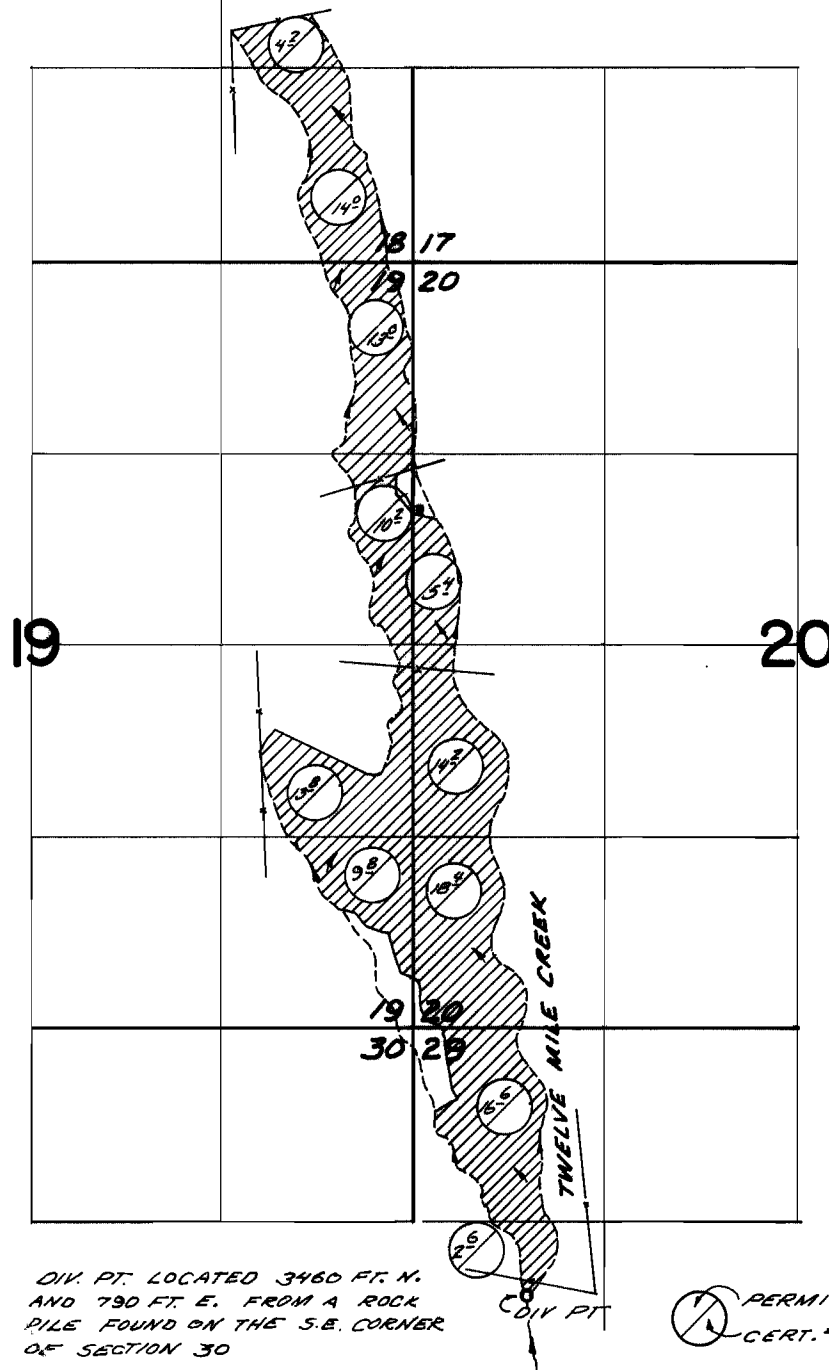

FINAL PROOF SURVEY
UNDER

Application No. 38862 Permit No. 28901
IN NAME OF

JOHN STODDART

Surveyed Oct. 25 1968, by V. Garner

Q-Z-Storie

1968-F