


T. 5S. R. 1 W. W.M.

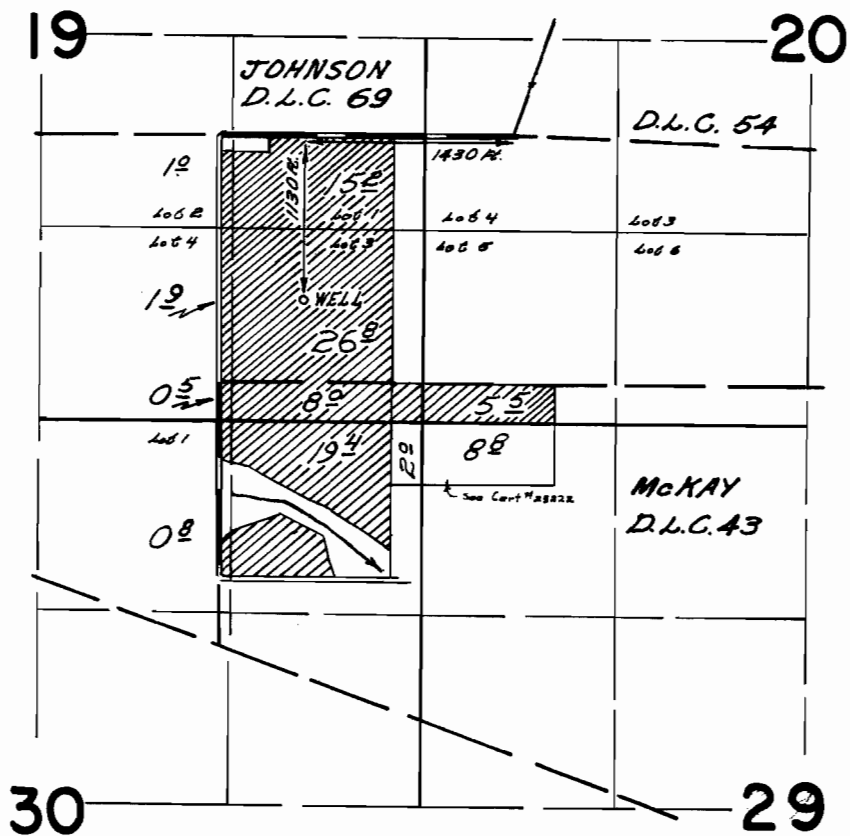

FINAL PROOF SURVEY UNDER

Application No. *G-2348* Permit No. *G-2192*
IN NAME OF

L. J. OBERSINNER

Surveyed *April 11, 1968*, by *W. d. Ruppert*