


# T. 8 S. R. 1 E. W. M.

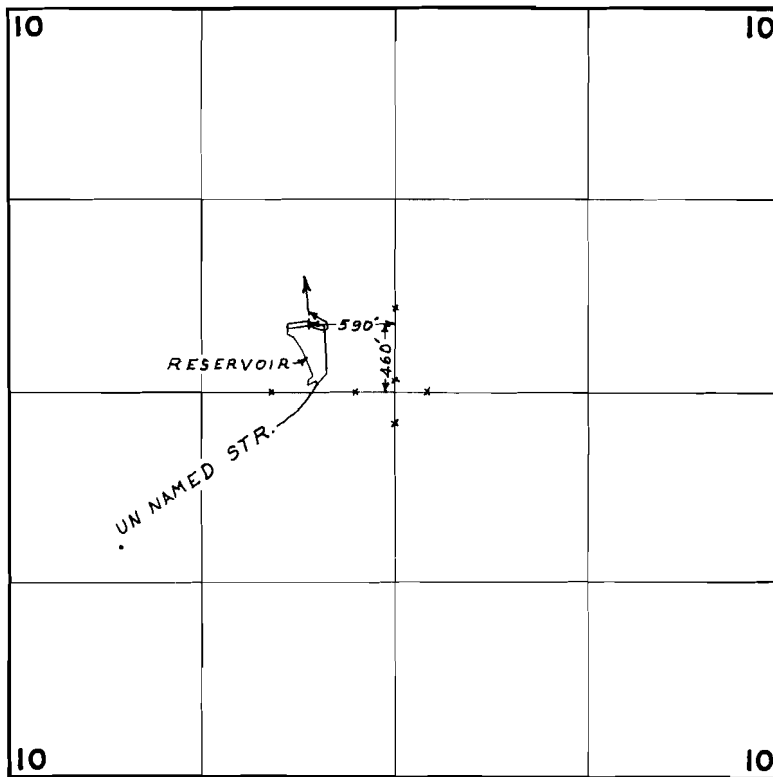

## FINAL PROOF SURVEY UNDER

R-40348                      R-4512  
Application No. **40349**    Permit No. **30086**  
IN NAME OF

**ELDON COOTER**.....

Surveyed **SEPT. 4 1968**, by **L. E. GOULD**