


T. 8 S. R. 1 E. W. M.

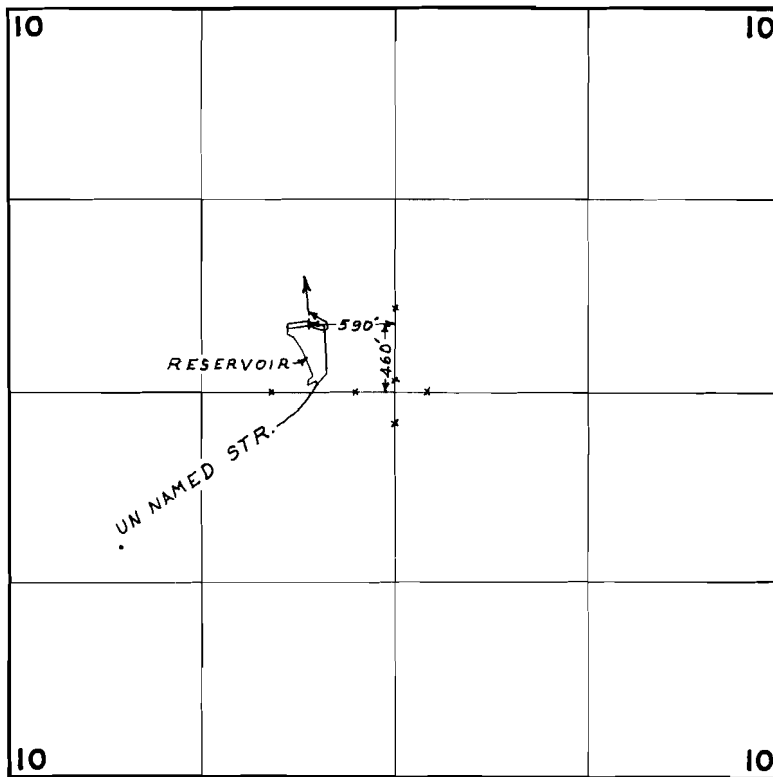

FINAL PROOF SURVEY UNDER

R-40348 R-4512
Application No. **40349** Permit No. **30086**
IN NAME OF

ELDON COOTER.....

Surveyed **SEPT. 4 1968**, by **L. E. GOULD**