


T.9S. R.38&4W.W.M.

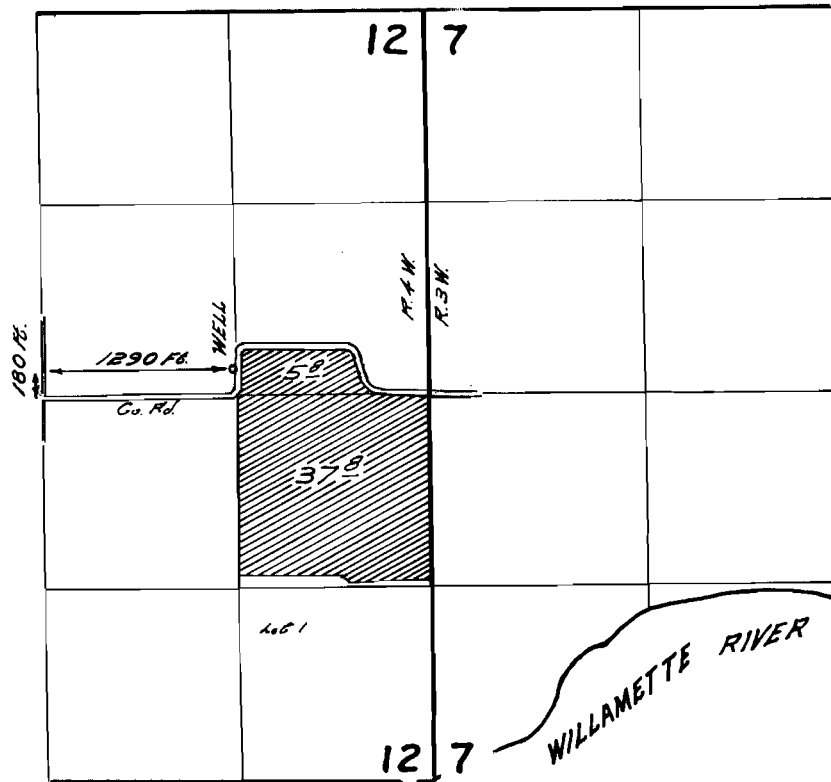

FINAL PROOF SURVEY
UNDER

Application No. *G-2784* Permit No. *G-2580*
IN NAME OF

GERALD MORLAN

Surveyed *August 14 1968*, by *W. J. Ruppert*