


T.8 S. R.6 W. W.M.

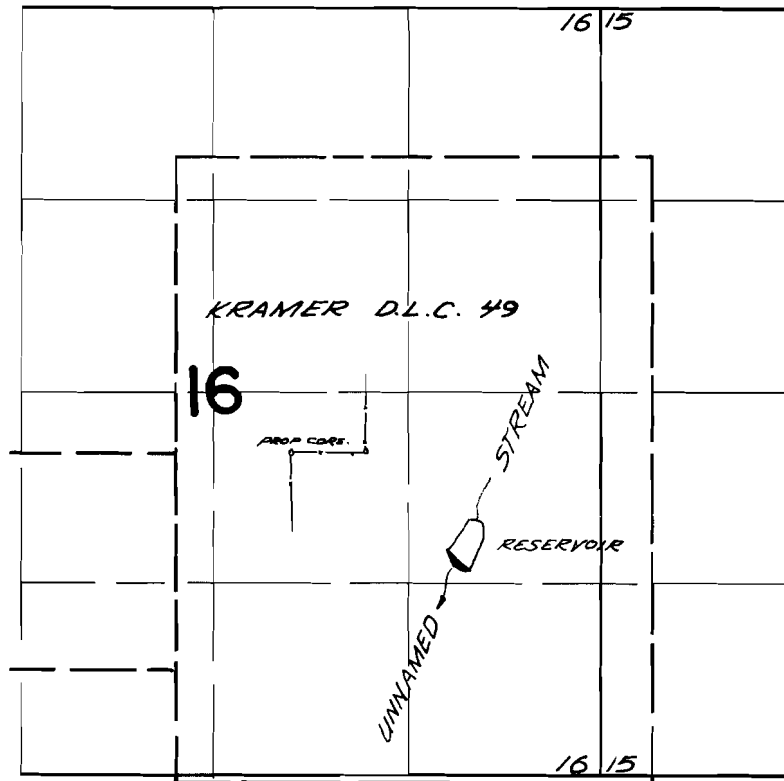

FINAL PROOF SURVEY
UNDER

Application No. *P-43218* Permit No. *P-4925*
IN NAME OF

RICHARD STEEN

Surveyed *Sept 24 1968*, by *W. J. Ruppert*