


T.8S. R.5W. W.M.

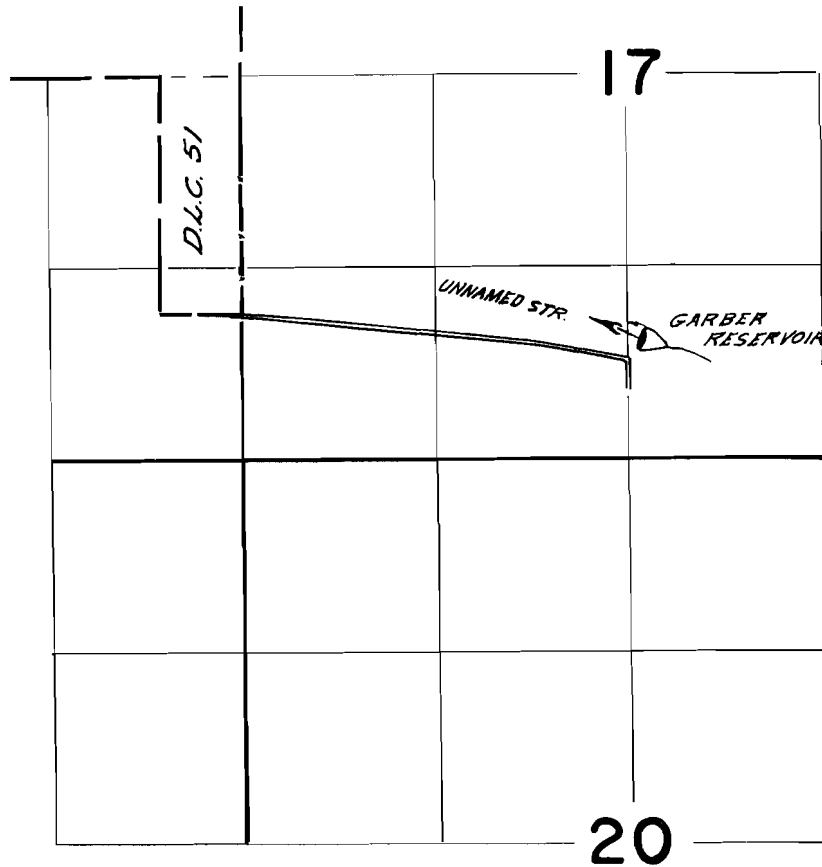

FINAL PROOF SURVEY
UNDER

Application No. *R-43172* Permit No. *R-4938*
IN NAME OF

KEITH E. NELSON

Surveyed *Sept. 6, 1968*, by *W.D. Fupper & S*