


T.6S.R.5W.W.M.

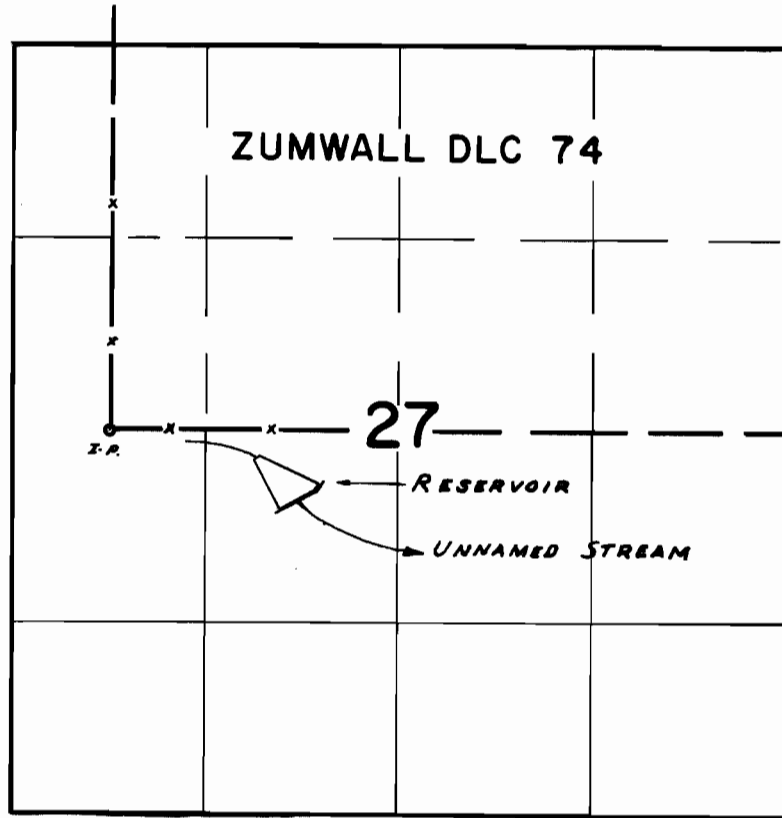

FINAL PROOF SURVEY UNDER

Application No. *R-43965* Permit No. *R-5059*
IN NAME OF

M. M. GILLES

Surveyed *Nov 24 1969*, by *R. Mucken*