


T. 10S. R. 4W. W.M.

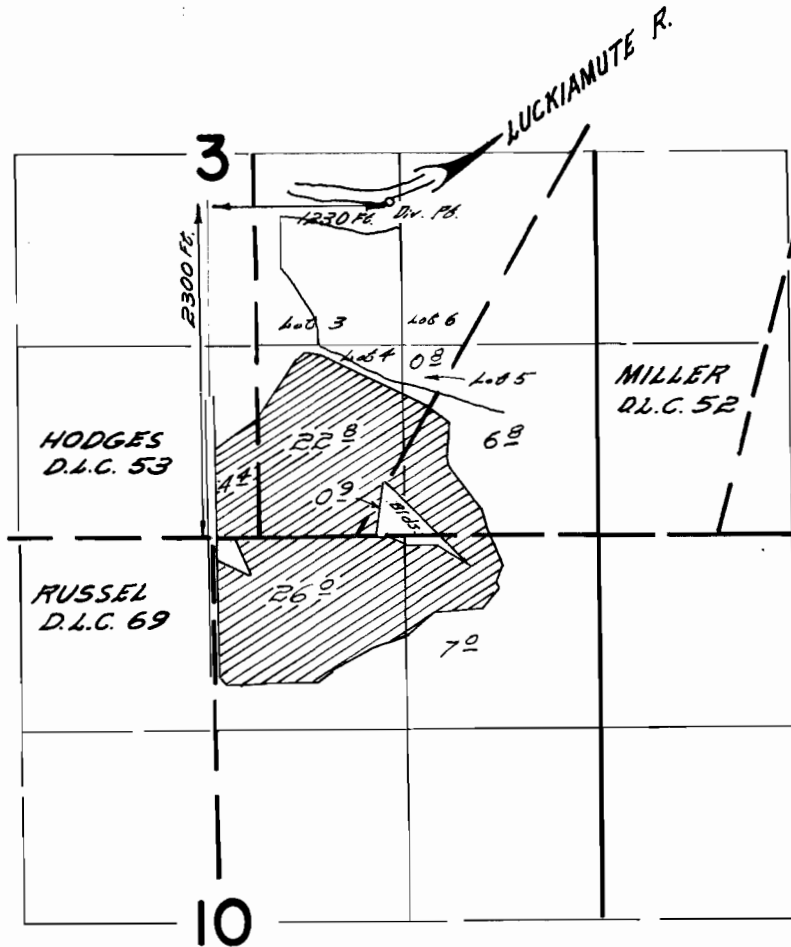

FINAL PROOF SURVEY
UNDER

Application No. 38617 Permit No. 28748
IN NAME OF

LYON & CAMPBELL

Surveyed August 12 1968, by *W.D. Puppert*