


# T.10S. R.4W. W.M.

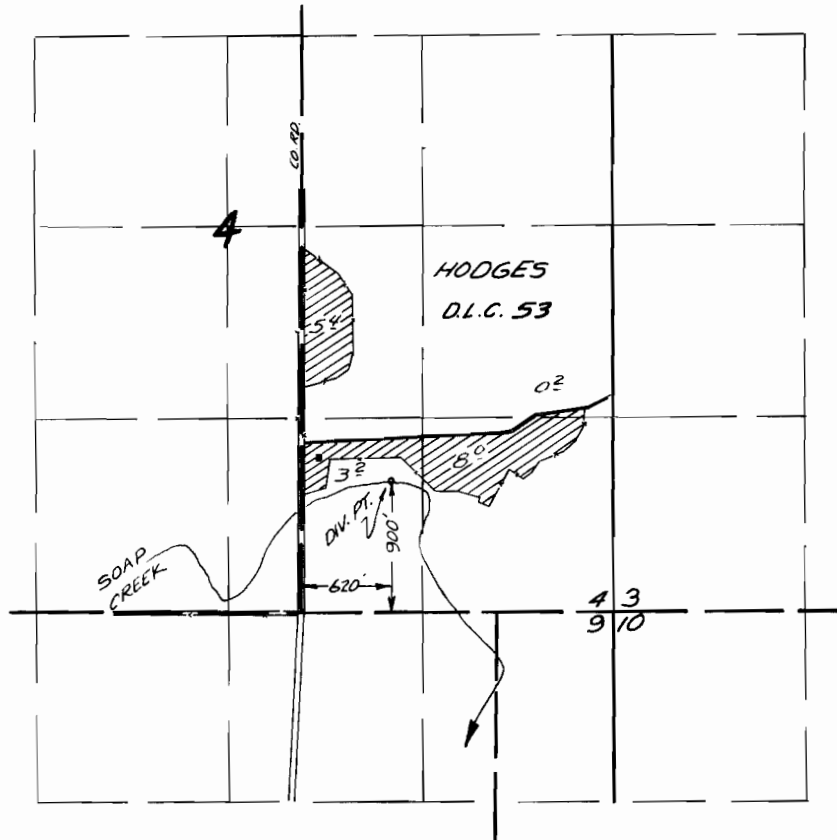

## FINAL PROOF SURVEY UNDER

Application No. 43086 Permit No. 32188  
IN NAME OF

*ROBERT GRIMPS*

Surveyed MARCH 31, 1969, by D.R. BUELL