


T. 1 S. R. 39 E. W.M.

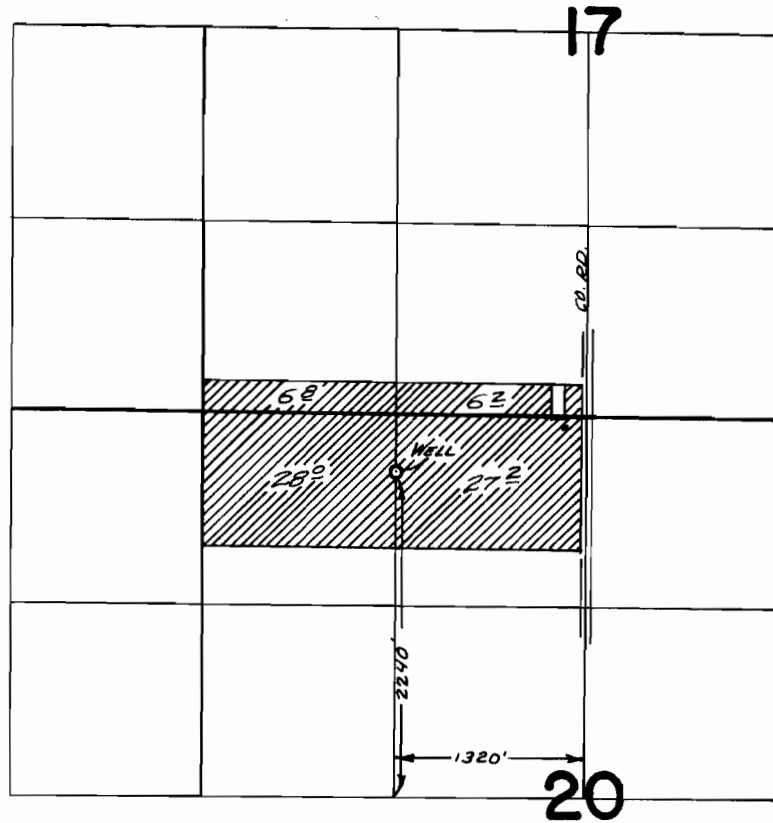

FINAL PROOF SURVEY UNDER

Application No. *G-2672* Permit No. *G-2508*
IN NAME OF

H. CLAYTON FOX

Surveyed *Aug 23, 1968*, by *V. Garner*