


T. 1 N. R. 39 E. W.M.

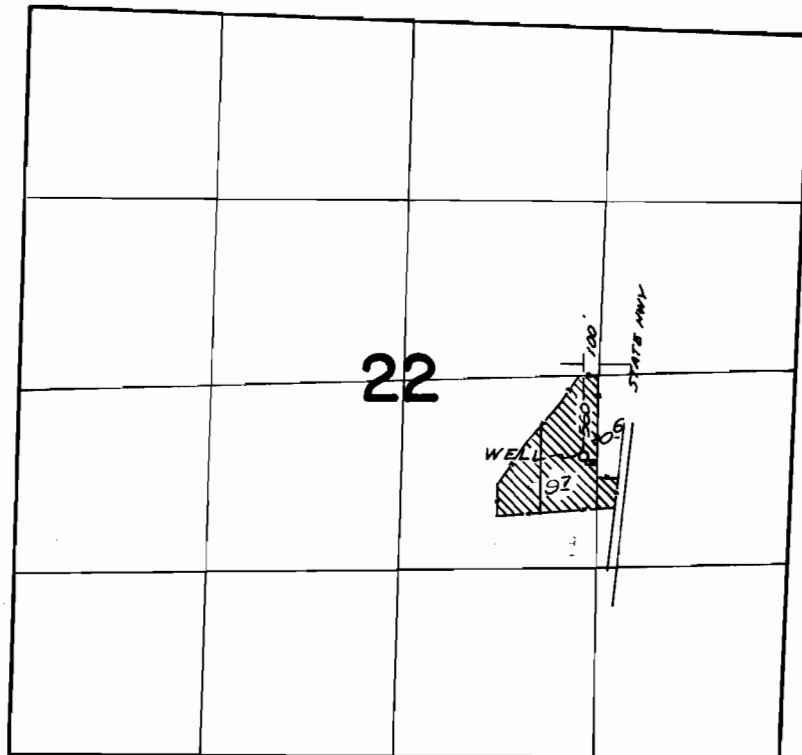

**FINAL PROOF SURVEY**  
UNDER

Application No. G-3263 Permit No. G-3061  
IN NAME OF

LEE T. and ETHEL L. FOLLETT

Surveyed Aug. 28, 1968, by V. Garner