


T. 3 S. R. 39 E. W. M.

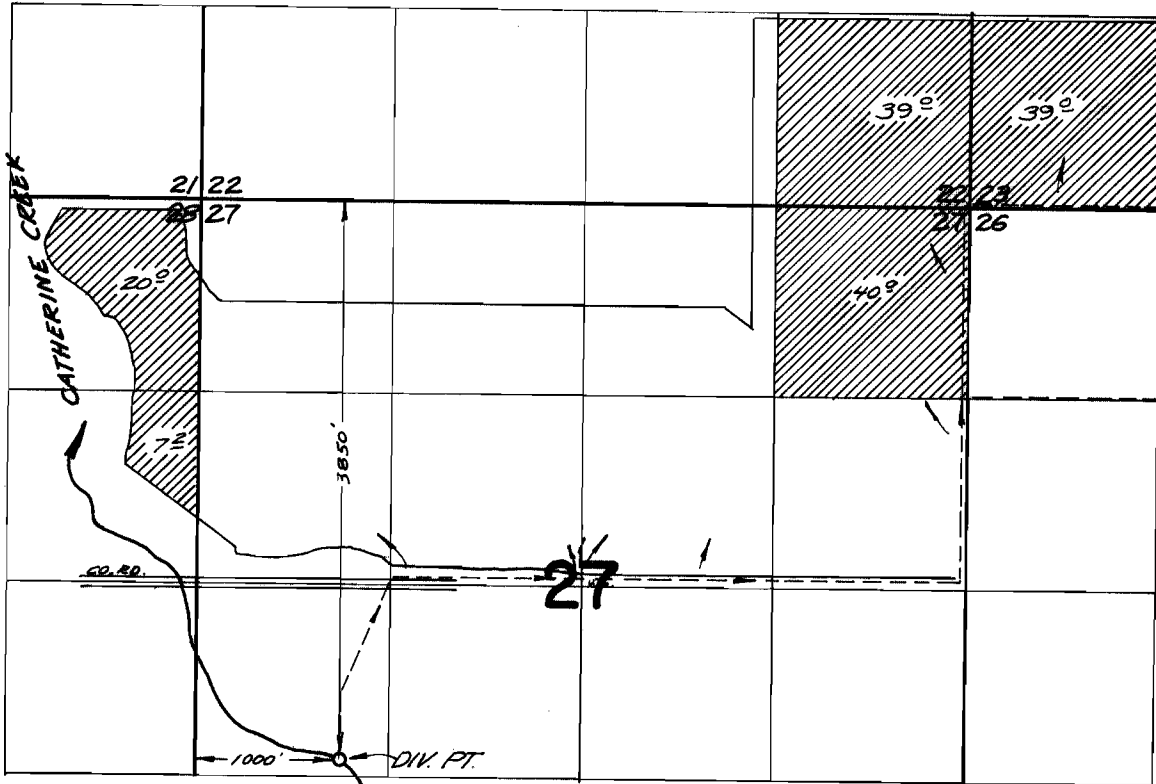

FINAL PROOF SURVEY
UNDER

Application No. 39132 Permit No. 29180
IN NAME OF

MABEL HUTCHINSON

Surveyed *AUG 24*, 1968, by *V. Garner*