


T. I N. R. 39 E. W. M.

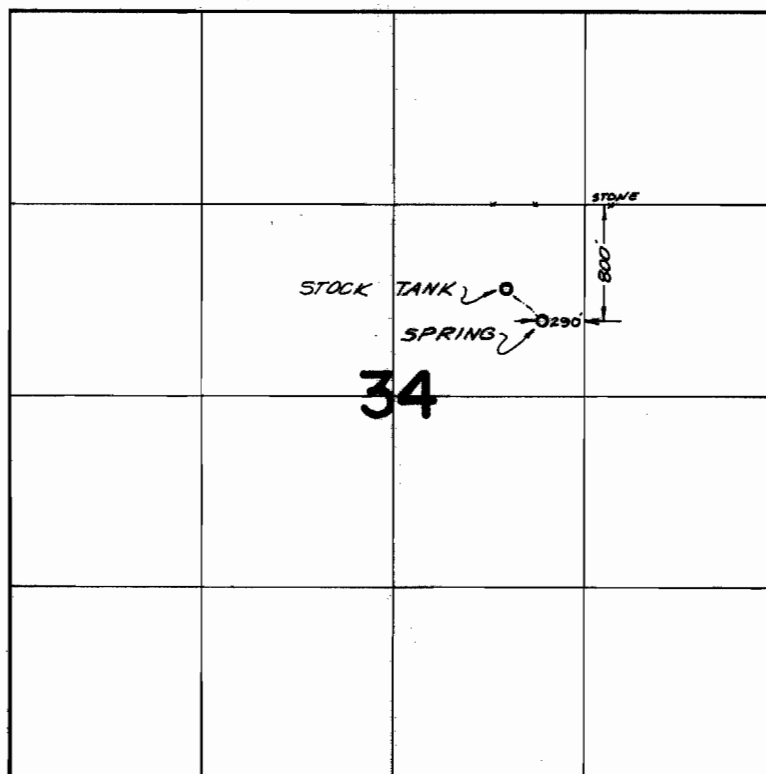

FINAL PROOF SURVEY
UNDER

Application No. 43761 Permit No. 32704
IN NAME OF

EVELYN HALLGARTH

Surveyed Aug 28 1968, by V. Gerner