


T. 3 S. R. 38 E. W.M.

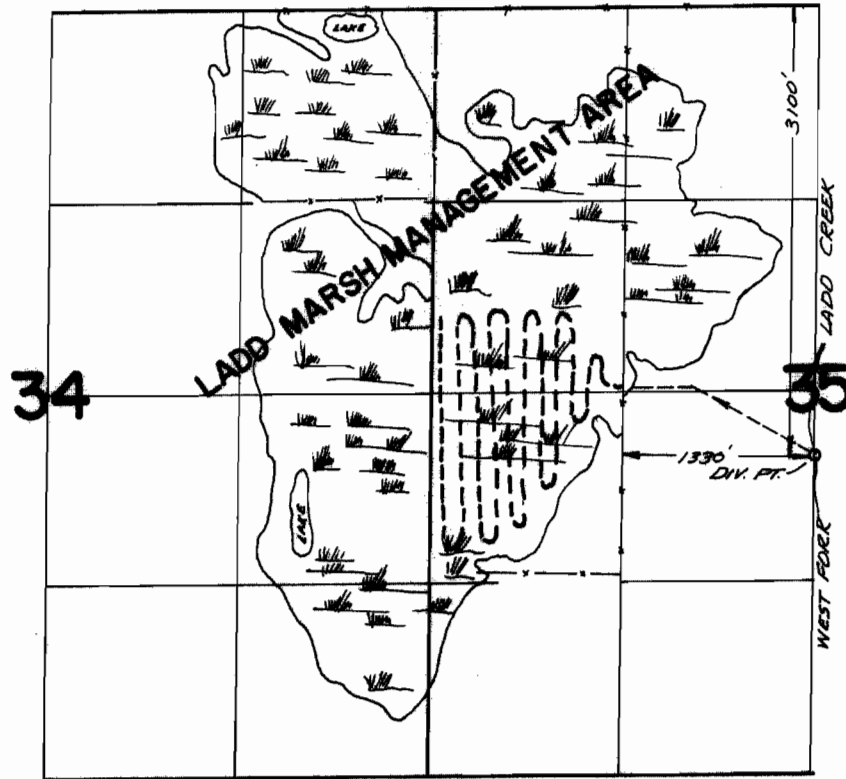

FINAL PROOF SURVEY UNDER

Application No. 43766... Permit No. 32707...
IN NAME OF

OREGON STATE GAME COMMISSION

Surveyed Aug 26, 1968, by *V. Garner*...